



# T. 27 S., R. 11 W. Sec. 27

Map for a pre-1909 Surface Water Registration.

Scale: 1" = 400 ft.



Date of Survey: 9-7-92.

This map is not the result of a property survey and is not to be used as such.

Applicant: Russell N. Heller.

SWR. 176

POD 1 is 450' N. + 1' E. of E 1/4 27/34.  
 POD 2 is 1645' N. + 560' E. of E 1/4 27/34.  
 POD 3 is 1669' N. + 510' E. of E 1/4 27/34.

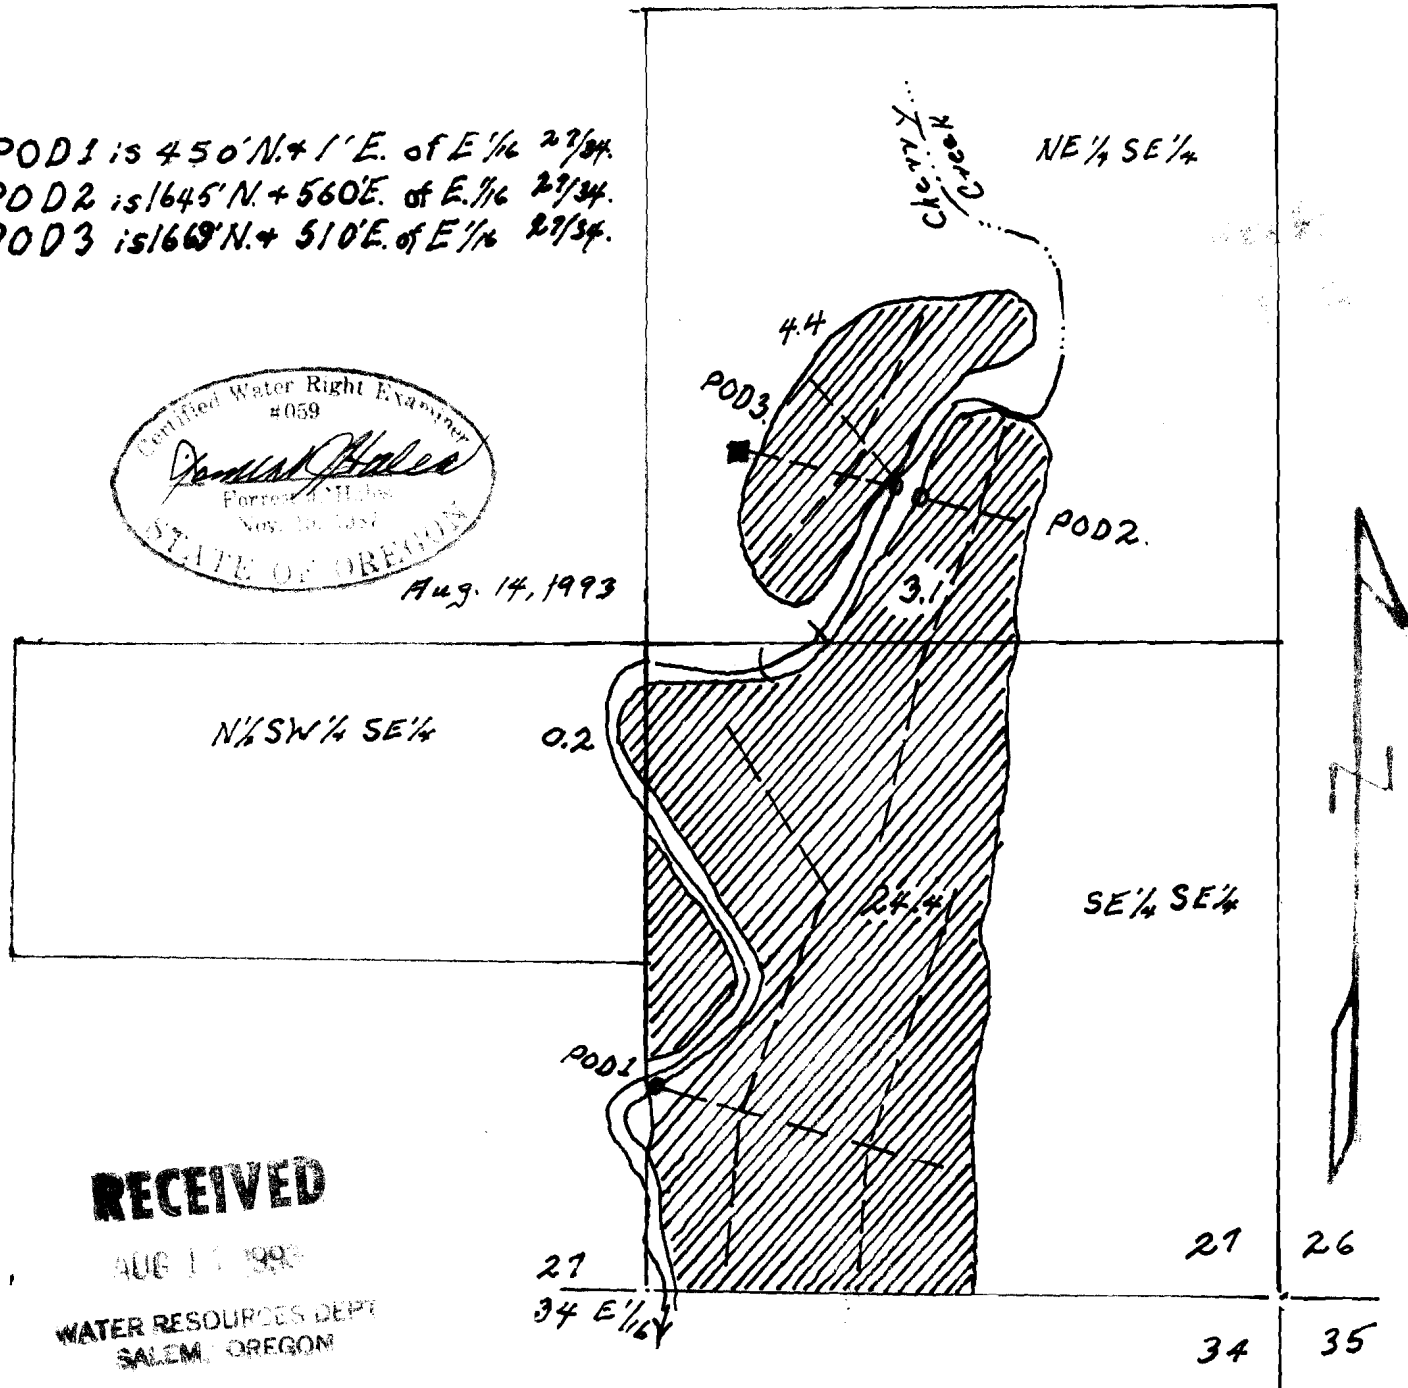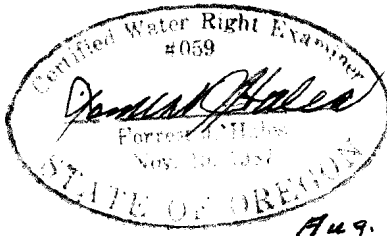

**RECEIVED**

AUG 17 1993

WATER RESOURCES DEPT  
SALEM, OREGON