


T27S, R3W, WM

SCALE 1" = 1320'
COUNTY OF DOUGLAS

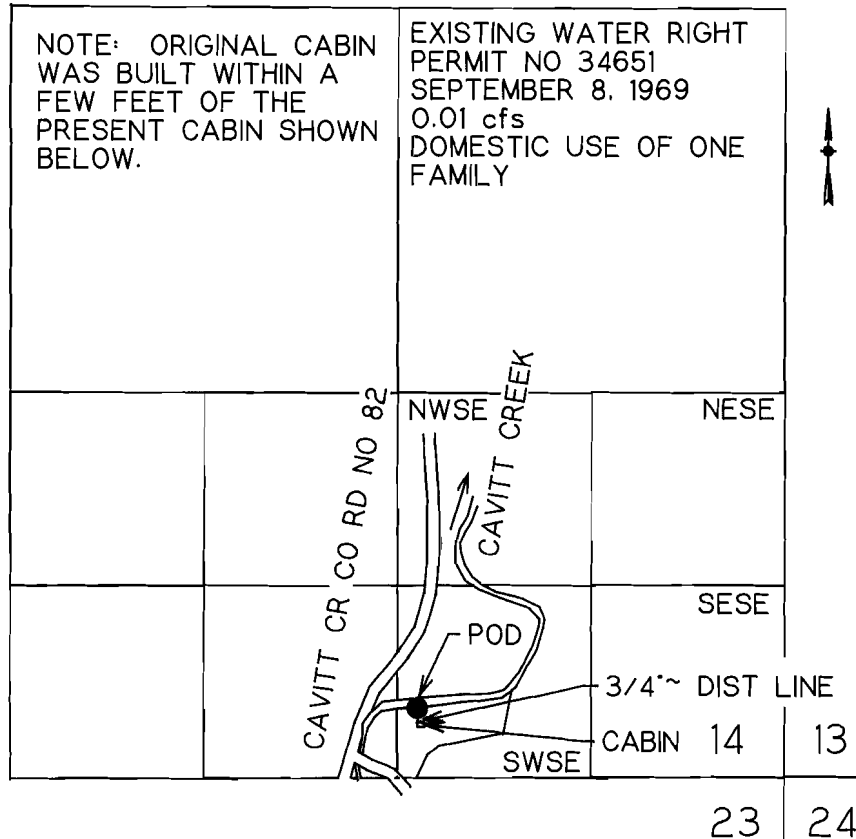


POD IS 480 FT N AND 140 FT E FROM S 1/4 COR SEC 14

VESTED WATER RIGHT MAP

PRE-1909 CLAIM OF BENEFICIAL USE

THIS IS A LOCATION MAP FOR A VESTED WATER RIGHT BY PHYLLISS A FELDKAMP TRUST. THIS MAP IS FOR THE PURPOSE OF IDENTIFYING THE LOCATION OF THE VESTED WATER RIGHT ONLY AND IS NOT INTENDED TO PROVIDE LEGAL DIMENSIONS OR LOCATIONS OF PROPERTY OWNERSHIP LINES.

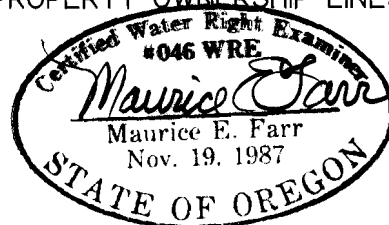

EXPIRES 12-31-95