


# BENEFICIAL USE

IN THE NAME OF: JAMES I. & CHARLOTTE PEARCE  
LOT 4, S33, T29S, R12W, WM

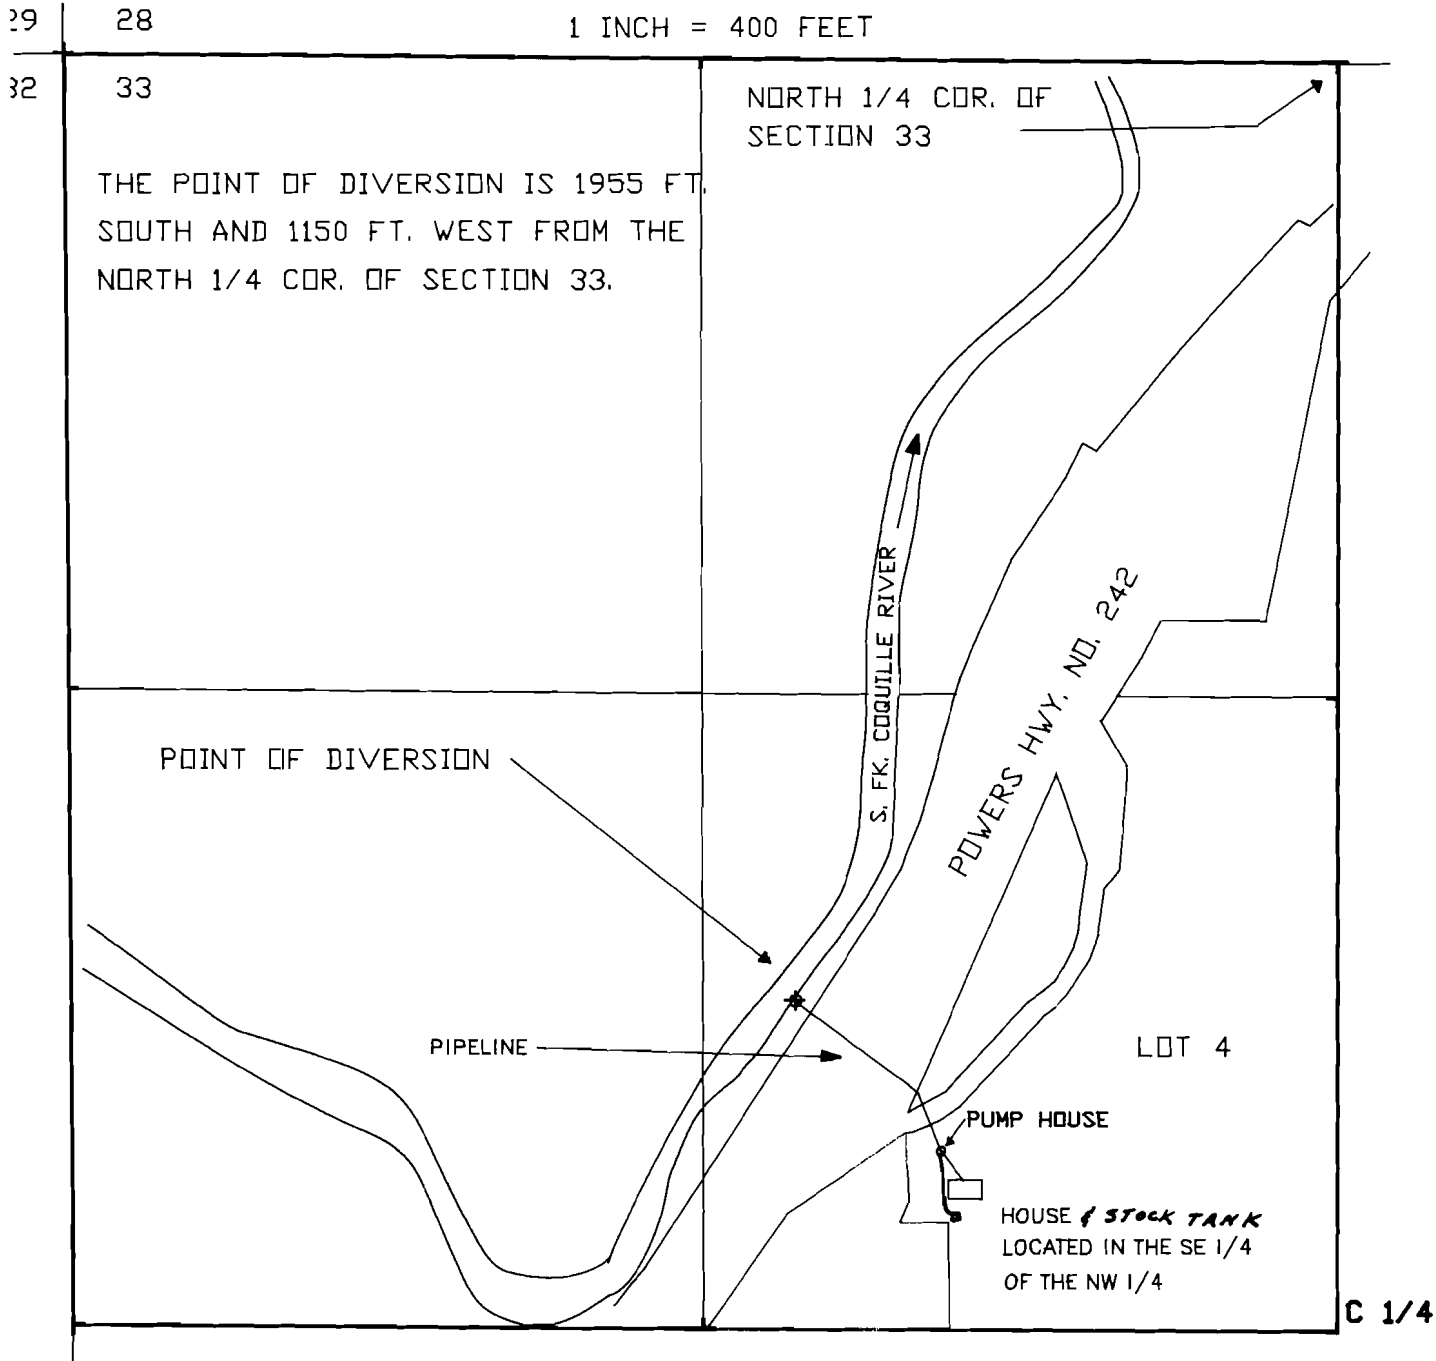

THE PURPOSE OF THIS MAP IS TO IDENTIFY THE LOCATION OF THE WATER RIGHT. IT IS NOT INTENDED TO PROVIDE INFORMATION RELATIVE TO THE LOCATION OF PROPERTY OWNERSHIP BOUNDARY LINES.

SURVEYED DECEMBER 6, 1992  
FILE NO. SWR-194

