


# RESERVOIR AND SURFACE WATER REGISTRATION MAP

IN THE NAME OF: CITY OF MILWAUKIE, OREGON


SECTION 25 T.1S R.1E W.M.  
SECTION 36 T.1S R.1E W.M.

UPPER SPILLWAY IS 80 FT. SOUTH AND 200 FT. EAST OF NW CORNER SECTION 36  
LOWER SPILLWAY IS 100 FT. NORTH AND 20 FT. WEST OF NW CORNER SECTION 36  
UPPER POND: AREA = 0.5 ACRES AND VOLUME = 0.75 ACRE-Feet  
LOWER POND: AREA = 0.2 ACRES AND VOLUME = 0.30 ACRE-Feet

1" = 400 Feet

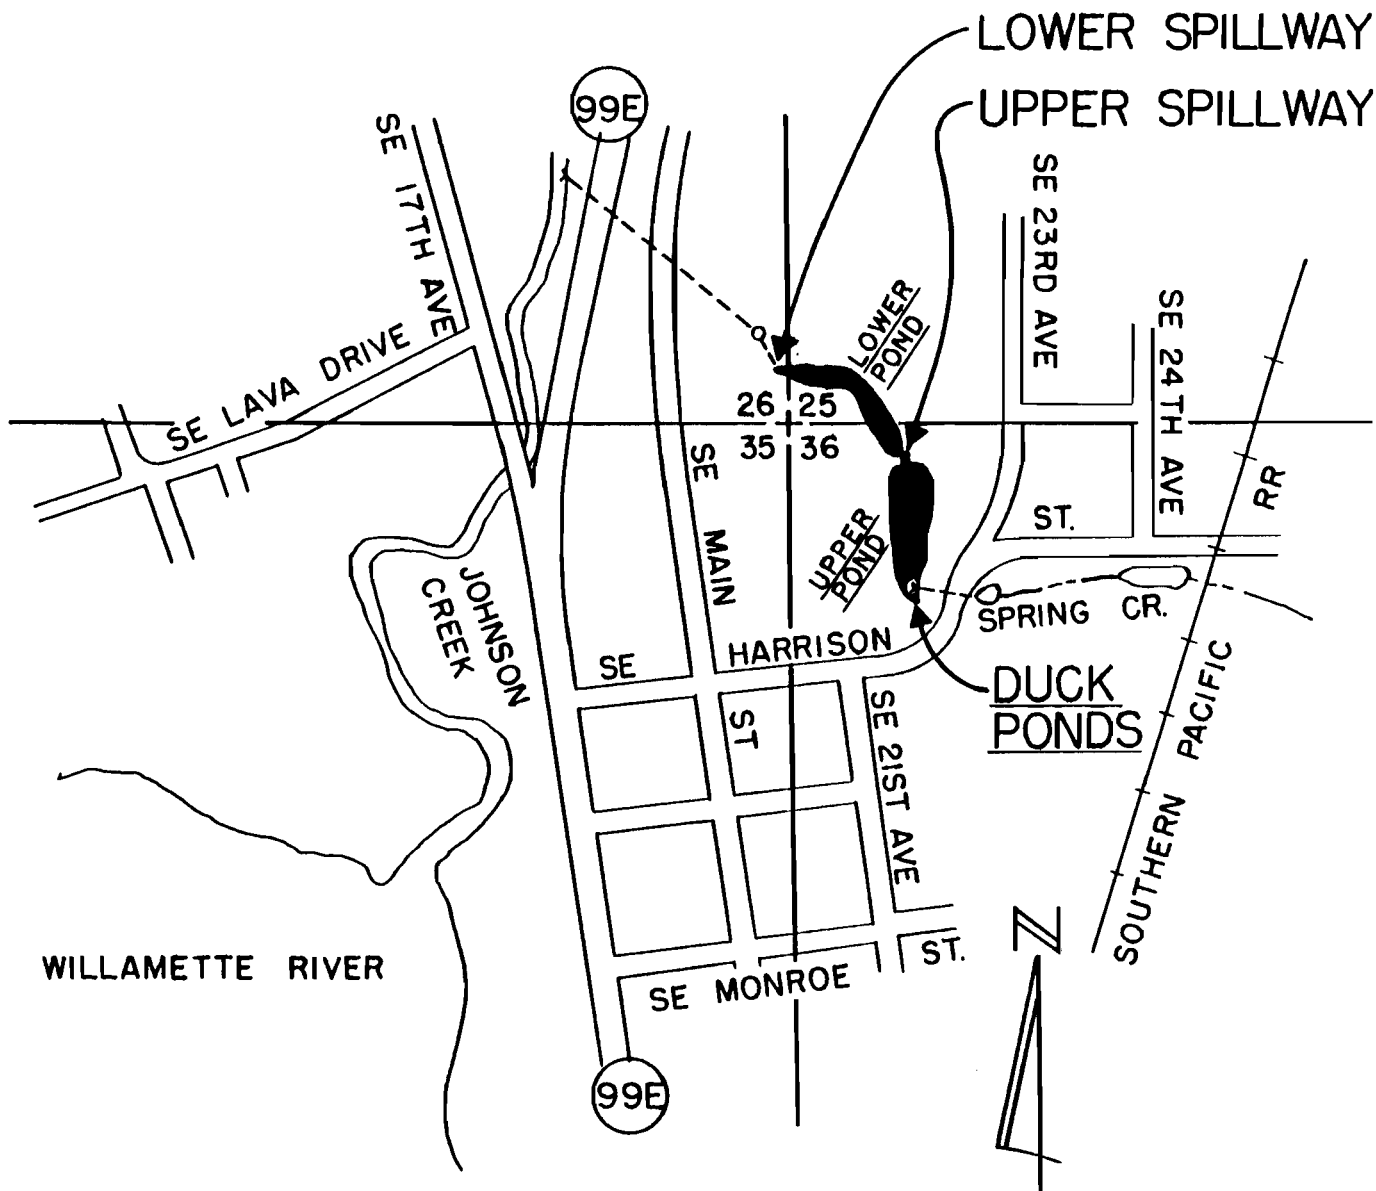

THE PURPOSE OF THIS MAP IS TO IDENTIFY THE LOCATION OF THE WATER RIGHT. IT IS NOT INTENDED TO PROVIDE INFORMATION RELATIVE TO THE LOCATION OF PROPERTY OWNERSHIP BOUNDARY LINES.

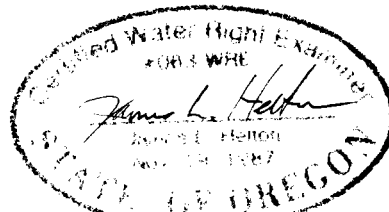

Expires 12-31-93

SURVEY DATE: 12-11-92