


T 7 S, R 4 W, WM

POLK COUNTY

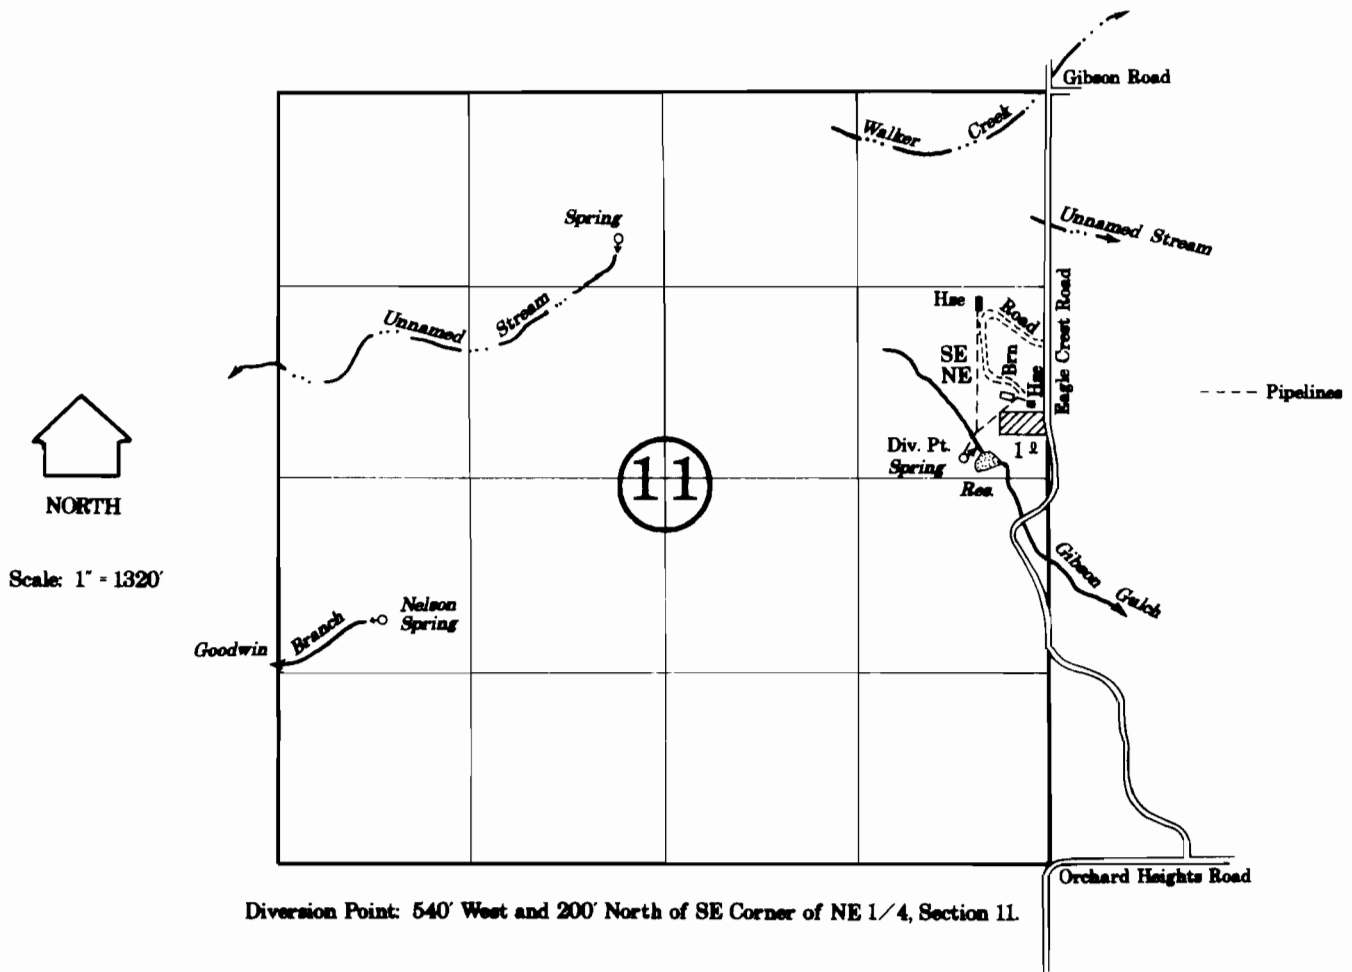

SURFACE WATER REGISTRATION STATEMENT PRE-1909 VESTED WATER RIGHT CLAIM

Richard C. and Jennie Lee Synowski

December 22, 1992

NOTE: This map is for the purpose of identifying the location of water rights and has no intent to dimension or locate property ownership lines.

