


T.4N., R.8W., W.M.
SECTION 8

RECEIVED

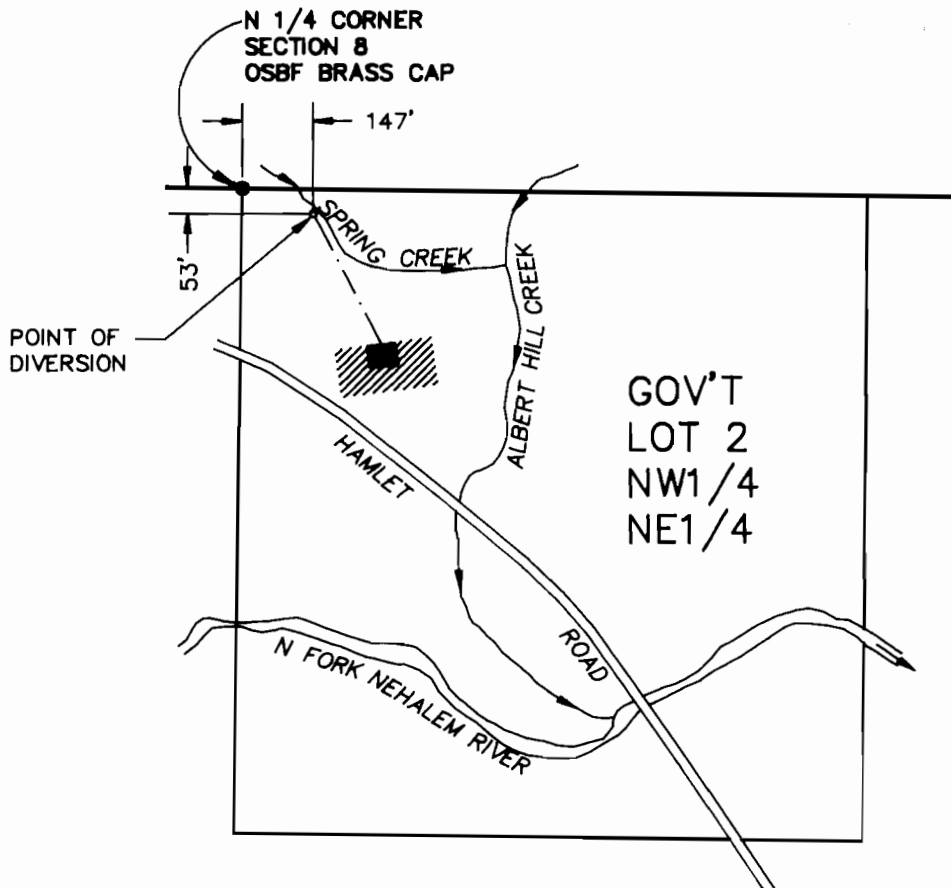

SCALE:
1" = 400'

CLAIM FOR A PRE-1909
ADJUDICATED WATER RIGHT

IN THE NAME OF
VERNON R. HILL

SURVEYED DEC. 7, 1992

THE PURPOSE OF THIS MAP IS TO IDENTIFY
THE LOCATION OF THE WATER RIGHT. IT IS
NOT INTENDED TO PROVIDE INFORMATION
RELATIVE TO THE LOCATION OF PROPERTY
OWNERSHIP BOUNDARY LINES.

