


THIS MAP IS FOR THE PURPOSE OF IDENTIFYING THE LOCATION OF WATER RIGHTS ONLY, AND IS NOT INTENDED TO PROVIDE LEGAL DIMENSIONS OR LOCATION OF PROPERTY LINES.

POINT OF DIVERSION INFORMATION

MOTOR: 20 H.P., 3 PH. ELEC.; 1750 RPM.; 43.8 AMPS; MAKE: U.S.

PUMP: 4 BELT, PULLY DRIVEN; DRIVE PULLY, 19"; OUTPUT PULLY, 8"; 3" DISCHARGE; MAKE: PARMA WATER LIFTER

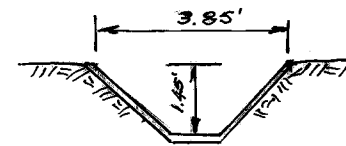

CONCRETE DITCH
1.8' BOTTOM - TYPICAL



SCALE: 1"=400'

FOUND BRASS CAP
34 35
BASIS OF BEARING
N 89° 57' 59" W 1321.88'

FOUND NO. 5 REBAR

T/6 S, R 47 E, W.M.
T/7 S, R 47 E, W.M.

SE 1/4 SE 1/4

10.9 ac. ±

35 36

LOT 1

LOT 2

LOT 3

LOT 4

TIE:

N 71° 35' W 4355.0'

17.0 ac. ±

38.0 ac. ±

12" GATED PIPE

10" PVC

POINT OF DIVERSION
EXIST. PUMP

5x3' CONC. RISER
w/ 14" OUTLET PIPE

8x6' CONC. RISER
w/ 10" OUTLET PIPES

DEAD OX CANAL

SNAKE RIVER

NOTES:

1. BASIS OF BEARING: RECORD OF SURVEY ON FILE IN OFFICE OF THE MALHEUR COUNTY SURVEYOR, SURVEY NO. 16-47-0044, DWG. NO. B-00525
2. THE DATE OF THIS SURVEY: 12-15-93
3. THE DIFFERENCE BETWEEN THE SURFACE OF THE WATER AT THE POINT OF DIVERSION AND THE MEAN ELEVATION OF THE IRRIGATED GROUND IS 11.8'
4. CROPS PRODUCED: ONIONS, ALFALFA HAY


RECEIVED

JAN 26 1994

WATER RESOURCES DEPT.
SALEM, OREGON

PRE-1909 CLAIM

UNDER
CLAIM NO. SWR 223
IN NAME OF
RICHARD AND JACQUELINE RULE

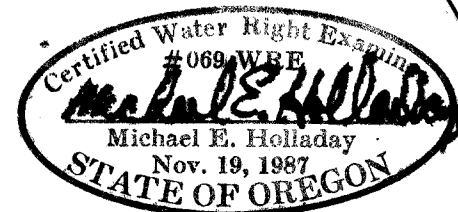

INSPECTED 12-20-93 BY Michael E. Holladay