


T27S, R3W, WM

SCALE 1" = 1320'

COUNTY OF DOUGLAS

SWR-236

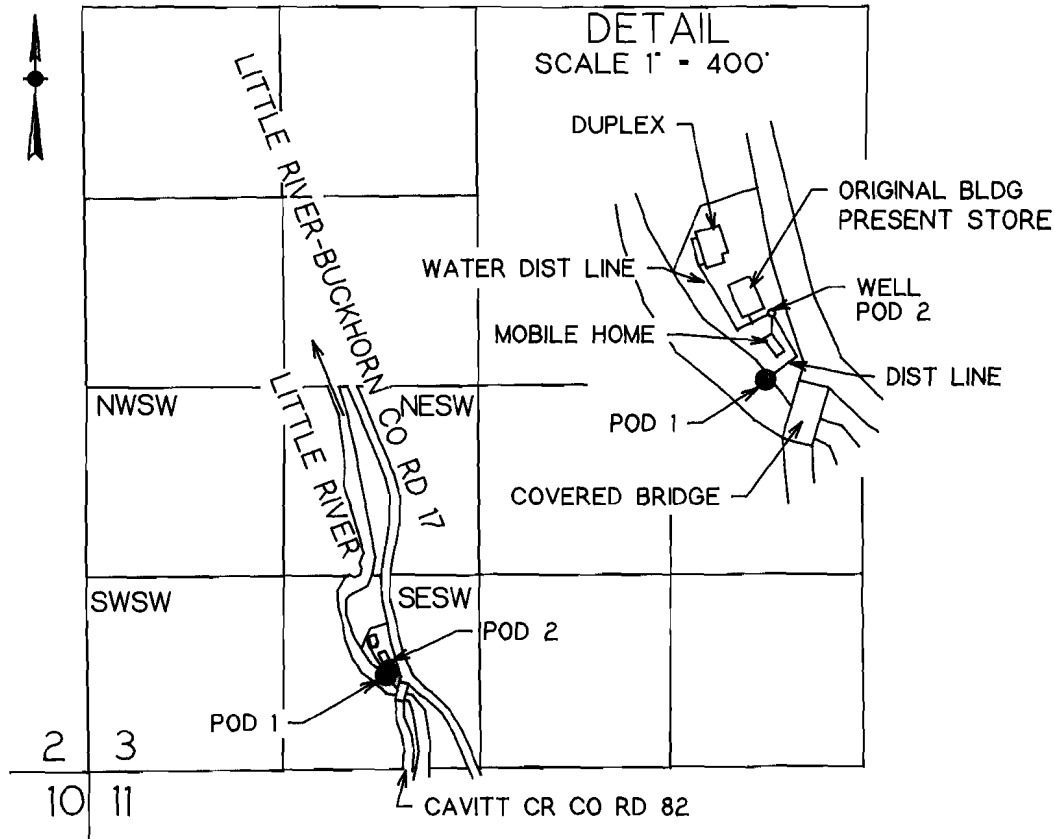

POD 1 IS 670 FT N AND 2050 FT E FROM SW COR SEC 3
POD 2 IS 770 FT N AND 2070 FT E FROM SW COR SEC 3

VESTED WATER RIGHT MAP


PRE-1909 CLAIM OF BENEFICIAL USE

THIS IS A LOCATION MAP FOR A VESTED WATER RIGHT BY JAMES H OR GRACE V WELLER. THIS MAP IS FOR THE PURPOSE OF IDENTIFYING THE LOCATION OF THE VESTED WATER RIGHT ONLY AND IS NOT INTENDED TO PROVIDE LEGAL DIMENSIONS OR LOCATIONS OF PROPERTY OWNERSHIP LINES.

RECEIVED

JUL 05 2005

WATER RESOURCES DEPT
SALEM, OREGON

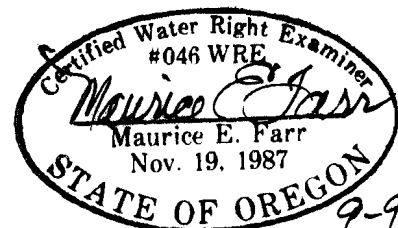

EXPIRES 12-31-95