



SURFACE WATER REGISTRATION STATEMENT MAP PRE-1909 WATER RIGHT CLAIM

RECEIVED

IN THE NAME OF CHARLES E. SPOONER

JUN 19 1987
WATER RESOURCE DEPT
SALEM OREGON

SECTION 24, TOWNSHIP 26 SOUTH, RANGE 4 WEST, W.M.

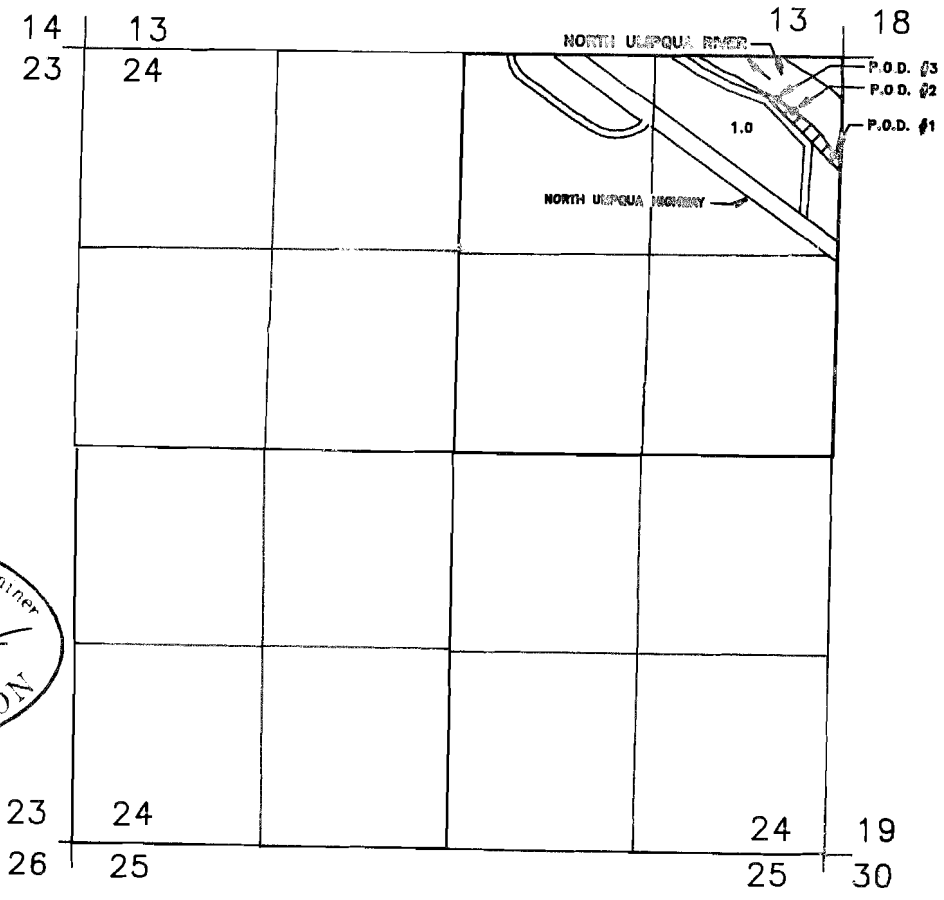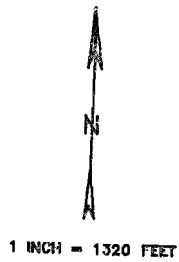

Certified Water Right Examiner
 #054 WRE
James F. Gosson
 James F. Gosson
 Nov. 19, 1987
 STATE OF OREGON

P.O.D. #	DISTANCE N OR S	DISTANCE E OR W	FROM	1/4 1/4	SECTION
1	650 S	20 W	NE COR S24	NE1/4 NE1/4	24
2	340 S	330 W	NE COR S24	NE1/4 NE1/4	24
3	270 S	450 W	NE COR S24	NE1/4 NE1/4	24

ALL POINTS OF DIVERSION BEING WITHIN TOWNSHIP 26 SOUTH, RANGE 4 WEST, W.M. DOUGLAS COUNTY.

THE PURPOSE OF THIS MAP IS TO IDENTIFY THE LOCATION OF THE WATER RIGHT. IT IS NOT INTENDED TO PROVIDE INFORMATION RELATIVE TO THE LOCATION OF PROPERTY OWNERSHIP BOUNDARY LINES.