

Section 9 Township 21S Range 11W W.M.
 Douglas County


N1/4

S4 S3
 S9 S10



CN1/16

N1/.16

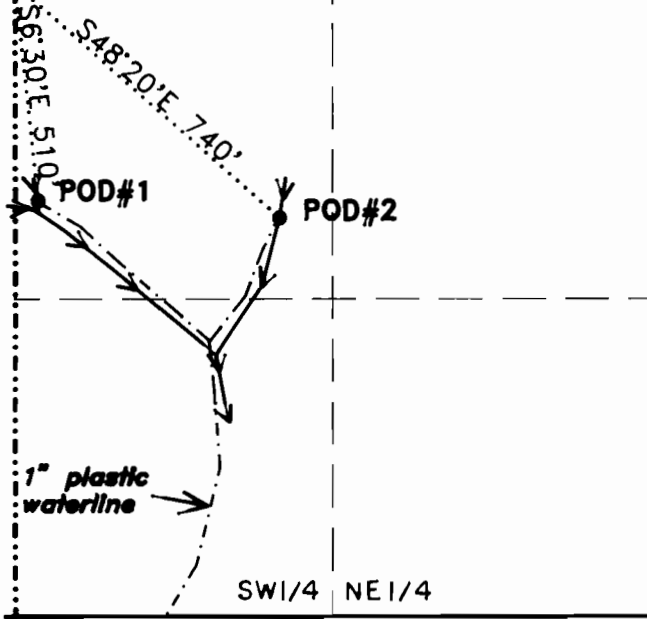

- Legend**
- P.O.D.
 - - - - Property Line
 - → → Creek
 - ◻ Home Including 1/2 acre Irrigation
 - - - - Waterline

SMITH RIVER

C1/4



NW1/4 SE1/4

CE1/16

E1/4


EXAMINERS DISCLAIMER STATEMENT

NOTE:

The P.O.D. and Waterline is entirely located on property owned by the applicant.

The preparation of this map was for the purpose of identifying the location of the Water Right only and has no intent to provide dimensions or location of property ownership lines.

PRE 1909 VEST WATER RIGHTS
 IN THE NAME OF
Gene Abbott

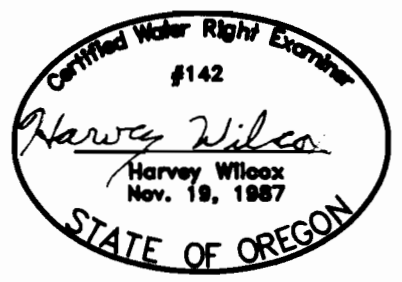

Surveyed on DECEMBER, 1992 by H.A. Wilcox