


RECEIVED

OCT - 7 1993

WATER RESOURCES DEPT.
SALEM, OREGON

**T. 10 S. R. 10 W. W.M.
SECTION 4
LOTS 33, 35, 36 & 38
LINCOLN COUNTY, OREGON**

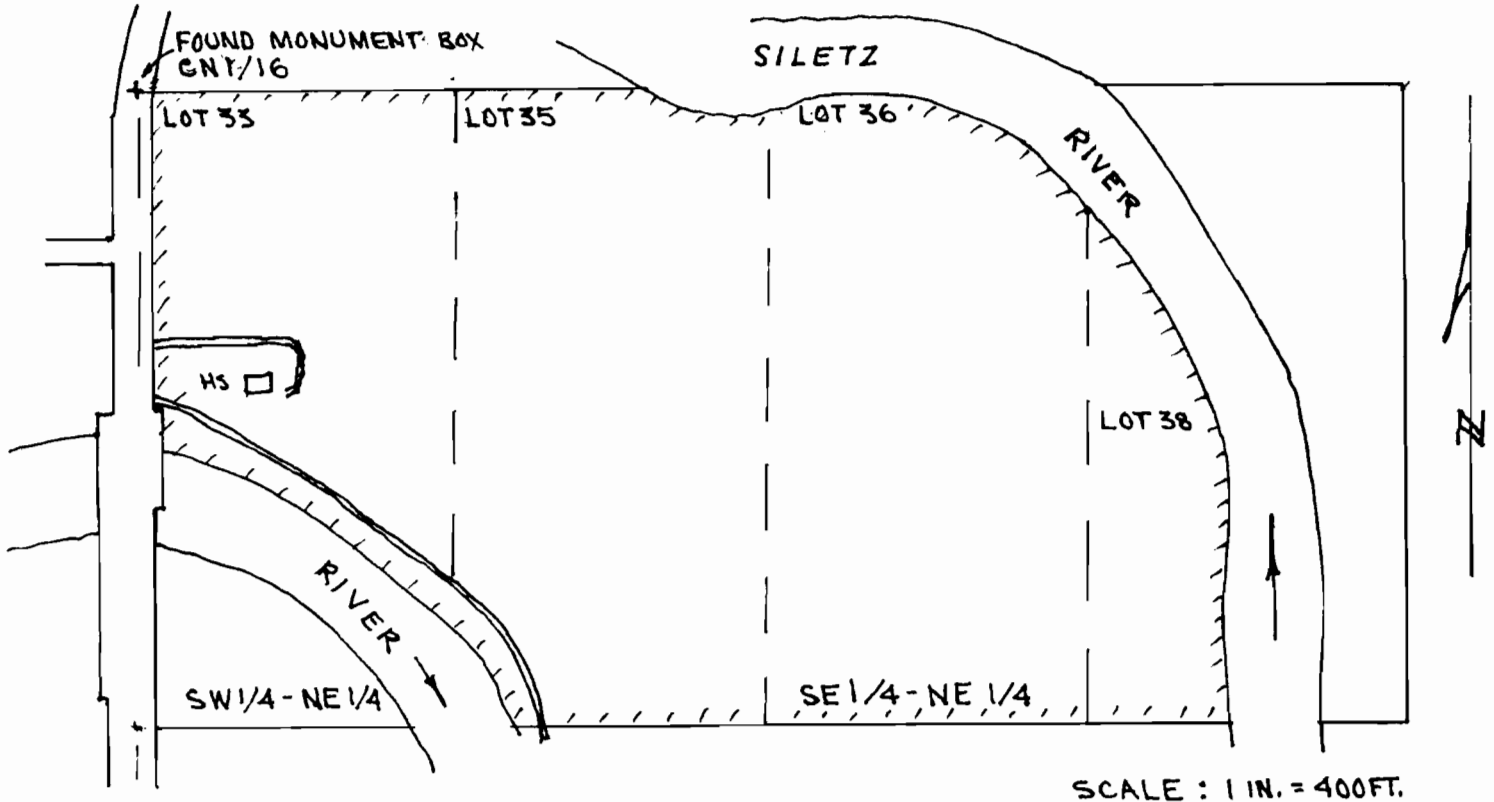

**CLAIM OF BENEFICIAL USE MAP
FOR**

**SURFACE WATER REGISTRATION STATEMENT PRE-1909 VESTED WATER
RIGHT CLAIM.**

APPLICATION# SWR-247


PERMIT# N/A

IN THE NAME OF

BENSELL LEWIS BREON

SURVEYED: SEPTEMBER 30, 1993

BY: J.M. DENISON

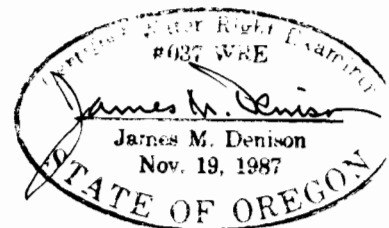

**This map prepared solely for the purpose of showing location of a water right, and is not
intended for use to provide dimensions or location of property ownership lines.**