


REGISTRATION STATEMENT MAP  
PRE-1909 VESTED WATER RIGHT CLAIM

IN THE NAME OF LOWELL OR MARY MEYER

SECTION 12, T 29 S, R 15 W, W.M.

SWR - 249

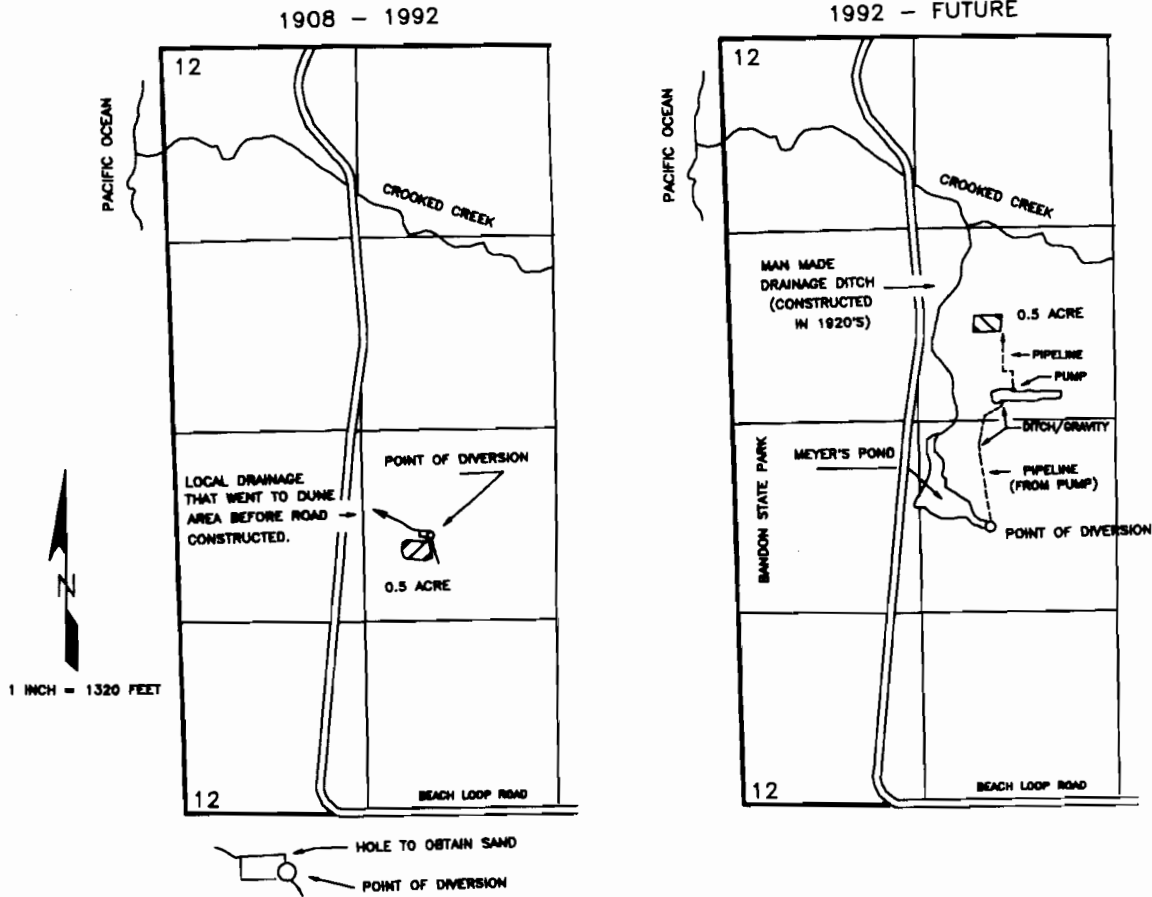

THE POINT OF DIVERSION IN 1908 AND CURRENTLY IS LOCATED 1900 FEET NORTH AND 1710 FEET EAST FROM THE SOUTHWEST CORNER OF SECTION 12, BEING WITHIN THE NE $\frac{1}{4}$ SW $\frac{1}{4}$  OF SECTION 12, TOWNSHIP 29 SOUTH, RANGE 15 WEST, W.M., IN COOS COUNTY.

NOTE: THE ORIGINAL BOG WAS FARMED UNTIL 1992 WHEN IT BECAME NECESSARY TO MOVE THE BOG AS SHOWN ON THE MAP.

THE PURPOSE OF THIS MAP IS TO IDENTIFY THE LOCATION OF THE WATER RIGHT. IT IS NOT INTENDED TO PROVIDE INFORMATION RELATIVE TO THE LOCATION OF PROPERTY OWNERSHIP BOUNDARY LINES.

