



T·27S·, R· 6 W, W·M·

SCALE: 1" = 1320'

REGISTRATION STATEMENT MAP

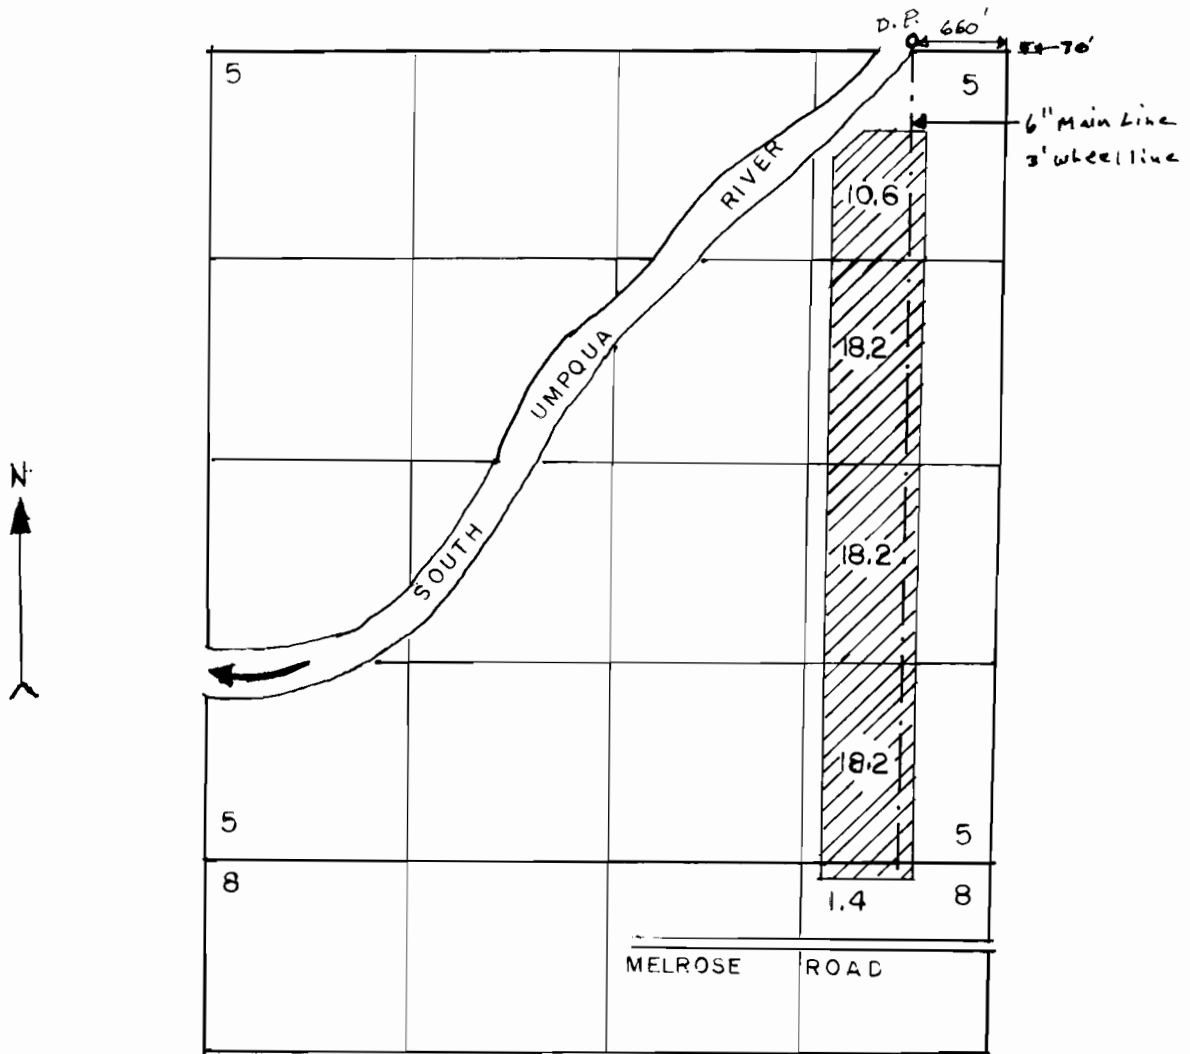

THE PURPOSE OF THIS MAP IS TO IDENTIFY THE LOCATION OF THE WATER RIGHT. IT IS NOT INTENDED TO PROVIDE INFORMATION RELATIVE TO THE LOCATION OF PROPERTY OWNERSHIP BOUNDARY LINES.

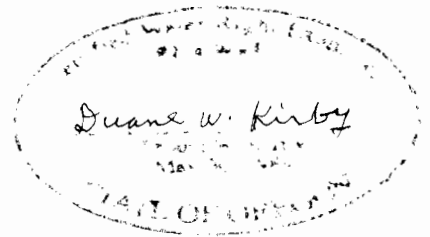

UNDER

IN NAME OF  
R. IMRIE CONN

Surveyed JAN. 18 1993, by DUANE KIRBY

SWR-200