


T.27S., R. 7 W., W.M.

SCALE: 1" = 1320'


REGISTRATION STATEMENT MAP

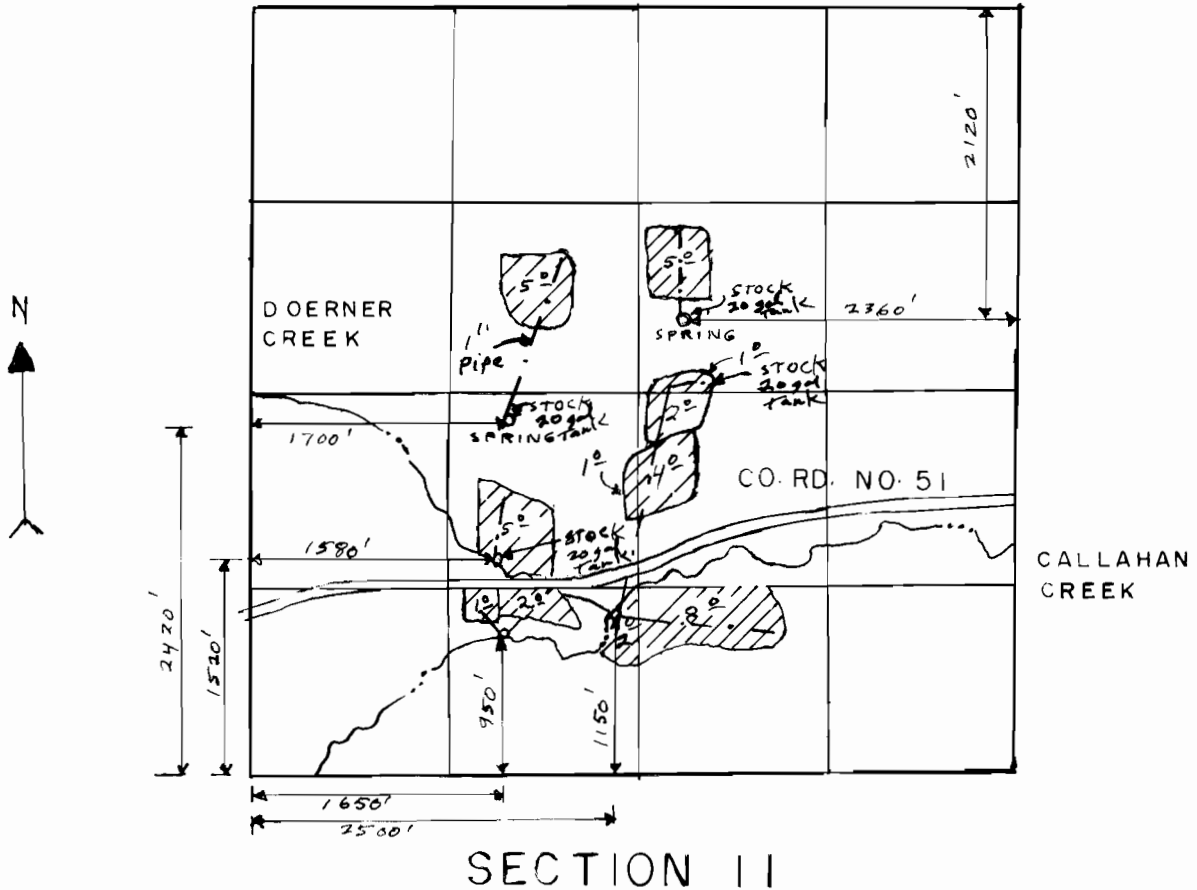

UNDER

THE PURPOSE OF THIS MAP IS TO IDENTIFY THE LOCATION OF THE WATER RIGHT. IT IS NOT INTENDED TO PROVIDE INFORMATION RELATIVE TO THE LOCATION OF PROPERTY OWNERSHIP BOUNDARY LINES.

Surveyed JAN. 20, 1993, by DUANE KIRBY

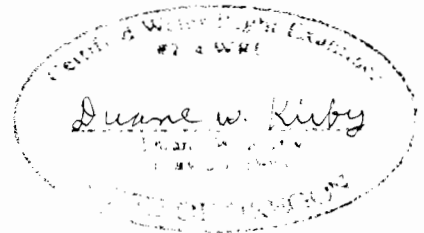

SWR-255