

TOWNSHIP 2 SOUTH, RANGE 4 EAST, W. M.


RECEIVED

NOV 04 1993


WATER RESOURCES DIVISION
SALEM, OREGON



Scale 1" = 400'

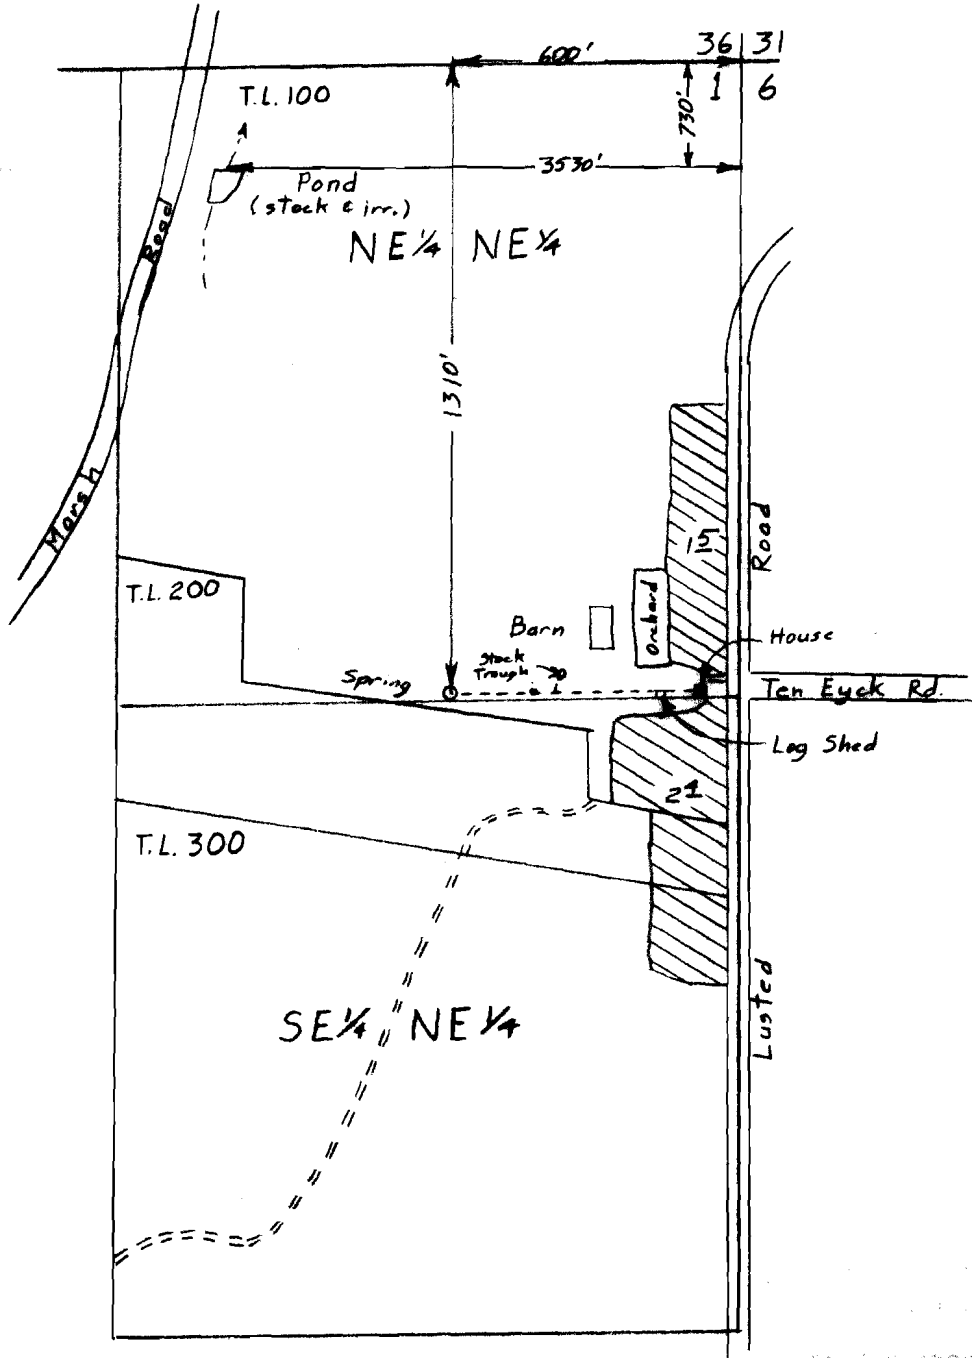

Adjudication Claim Map
for
PAULINE E. BUHLER
&
ULRICK E. BUHLER

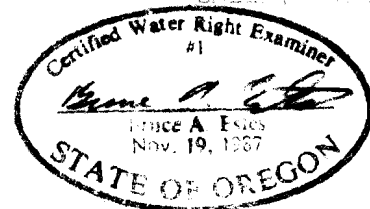

This map is for the purpose of locating a water right only and has no intent to provide legal dimensions or the location of property lines.