


CLAIM OF BENEFICIAL USE MAP

FRED MAZE
File No. SWR-280

SECTION 12, T24S, R13W, W. M.

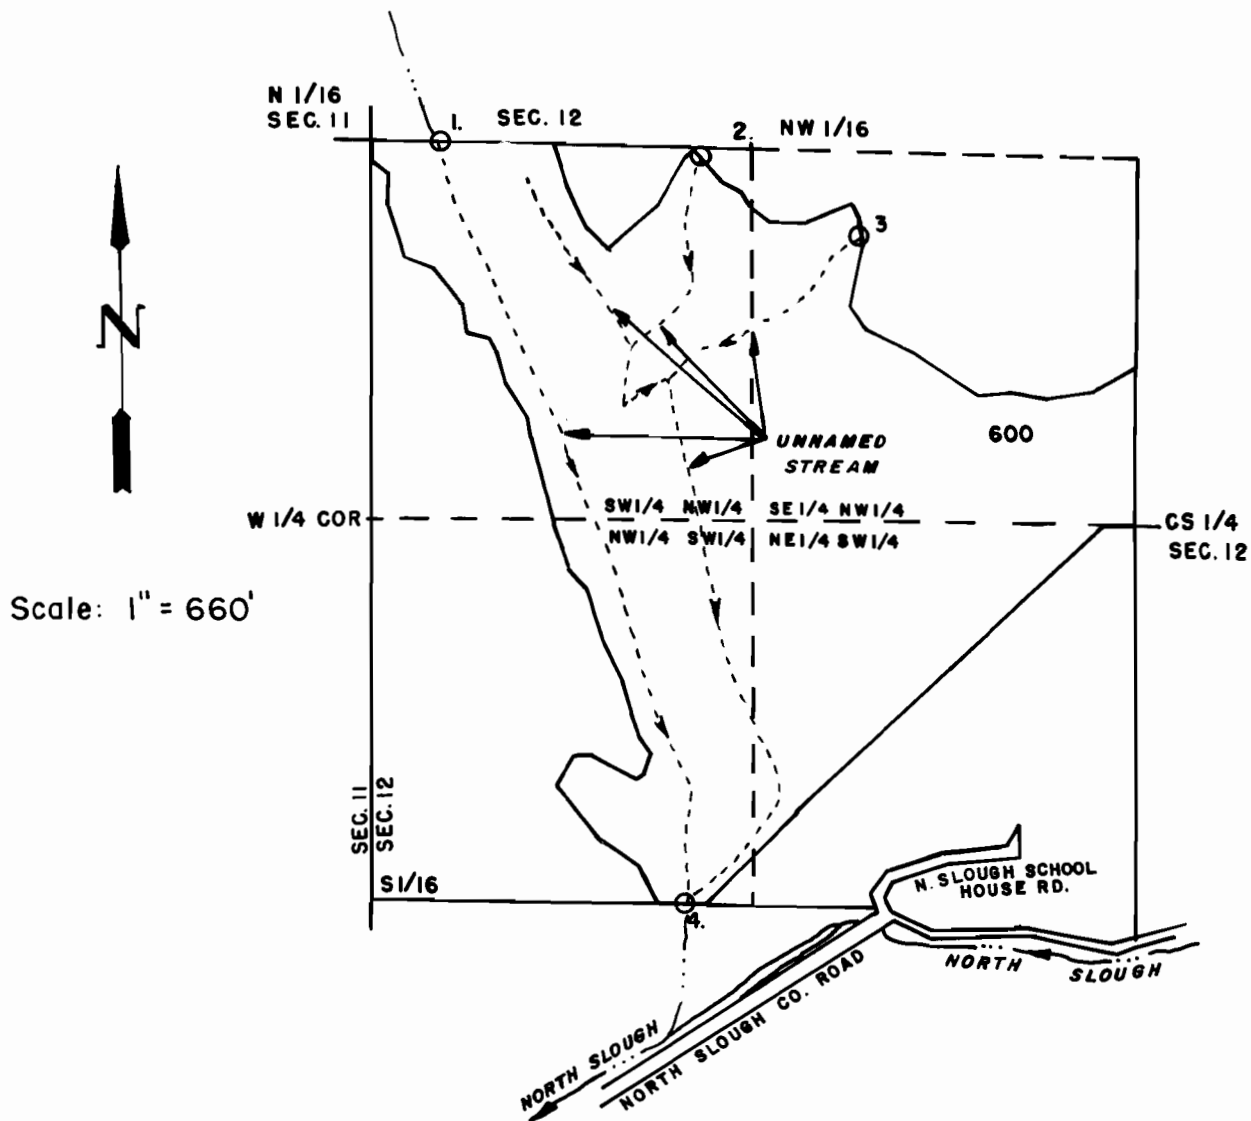


Points of Stream Entry Onto Property

1. N 12° 11' E 1321' from the W 1/4 corner between sections 11 & 12.
2. N 44° 13' E 1729' from the W 1/4 corner between sections 11 & 12.
3. N 61° 13' E 1996' from the W 1/4 corner between sections 11 & 12.

Point of Stream Exit From Property

4. S 38° 47' E 1741' from the W 1/4 corner between sections 11 & 12.

--- Reach of streams used for livestock watering

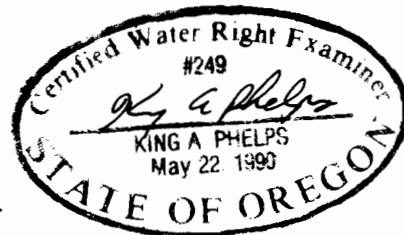

THE PURPOSE OF THIS MAP IS TO IDENTIFY THE LOCATION OF THE WATER RIGHT IT IS NOT INTENDED TO PROVIDE INFORMATION RELATIVE TO THE LOCATION OF PROPERTY OWNERSHIP BOUNDARY LINES.