

T. 29 and T. 30 S., R. 12 W. Sec. 32 and 6
Map for a pre-1909 Surface Water Registration.


Scale: 1" = 400ft.

Date of Survey: 11-25-92



This map is not the result of a property survey
and is not to be used as such.

Applicant: Alan B. Hermann

P.O.D. is 820 ft. N. + 650 ft. W. of
S. 1/4 Cor Sec. 32

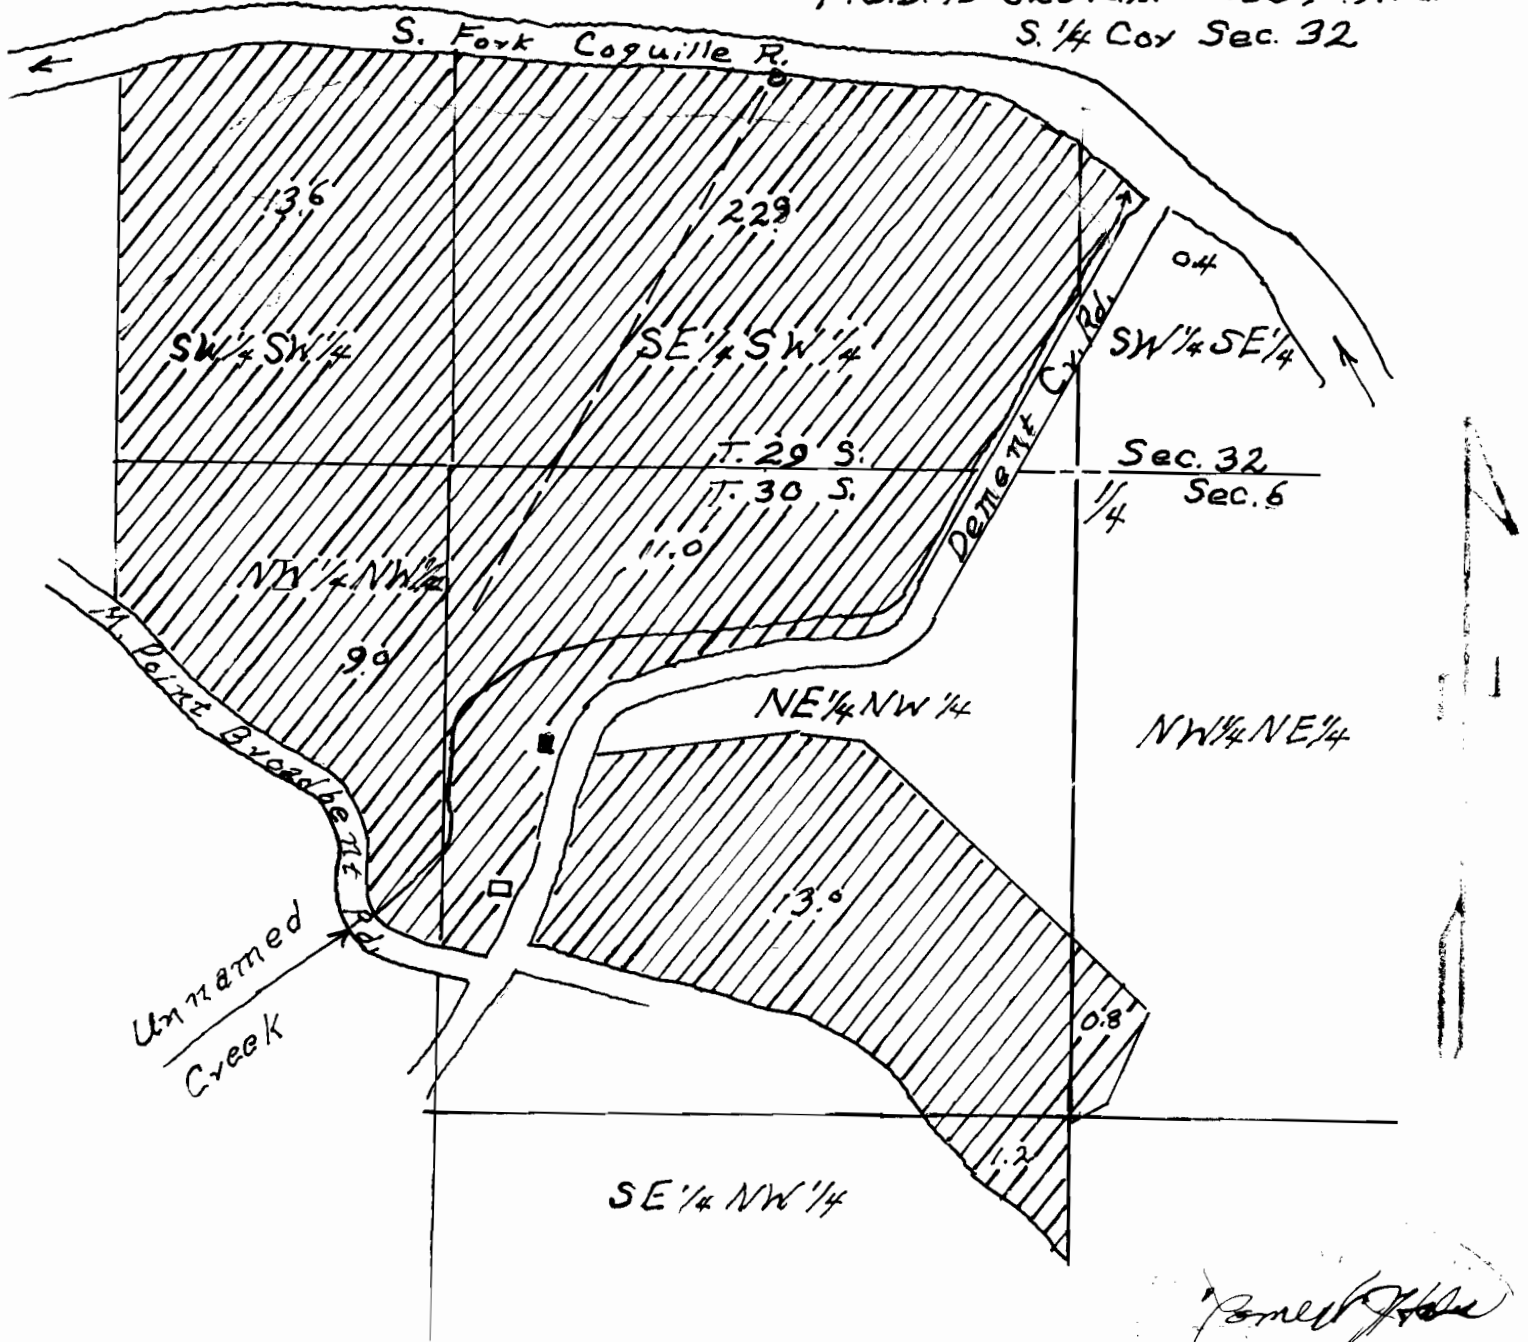

T. 30 S., R. 12 W. Sec. 5 and 6
 Map for a pre-1909 Surface Water Registration
 Scale: 1" = 1320ft. Date of survey: Nov. 25, 1992.
 This map is not the result of a property survey
 and is not to be used as such.
 For: Alan B. Hermann.

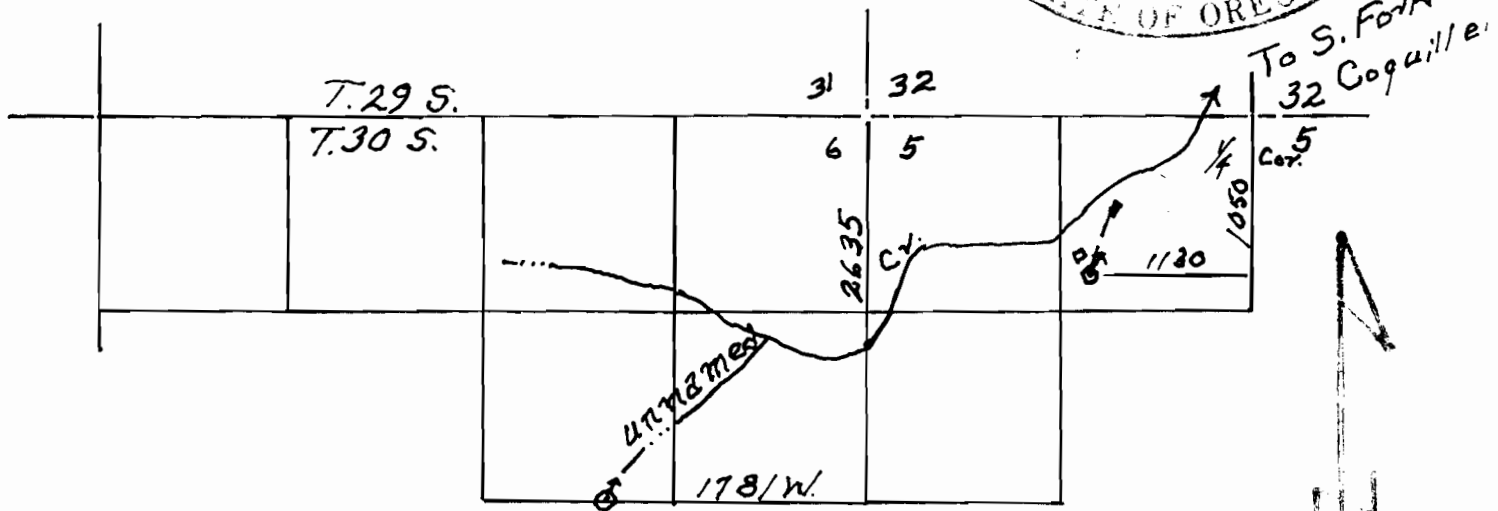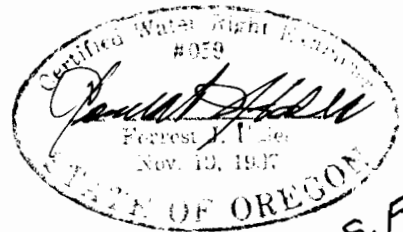

Note: All coordinates shown on this map were measured from A. Photo No. 41011-180-225X.