T. 29 S., R. 13 W. W. M.

Map for pre-1909 Surface Water Registration

Scale: 1" = 1320' Date of Survey: 11-25-9

This map is not the result of a property survey and is not to be used as such.

For: Charles E. King

Certified Water Right Examiner #059
Forrest J. Hales
Nov. 19, 1987
STATE OF OREGON

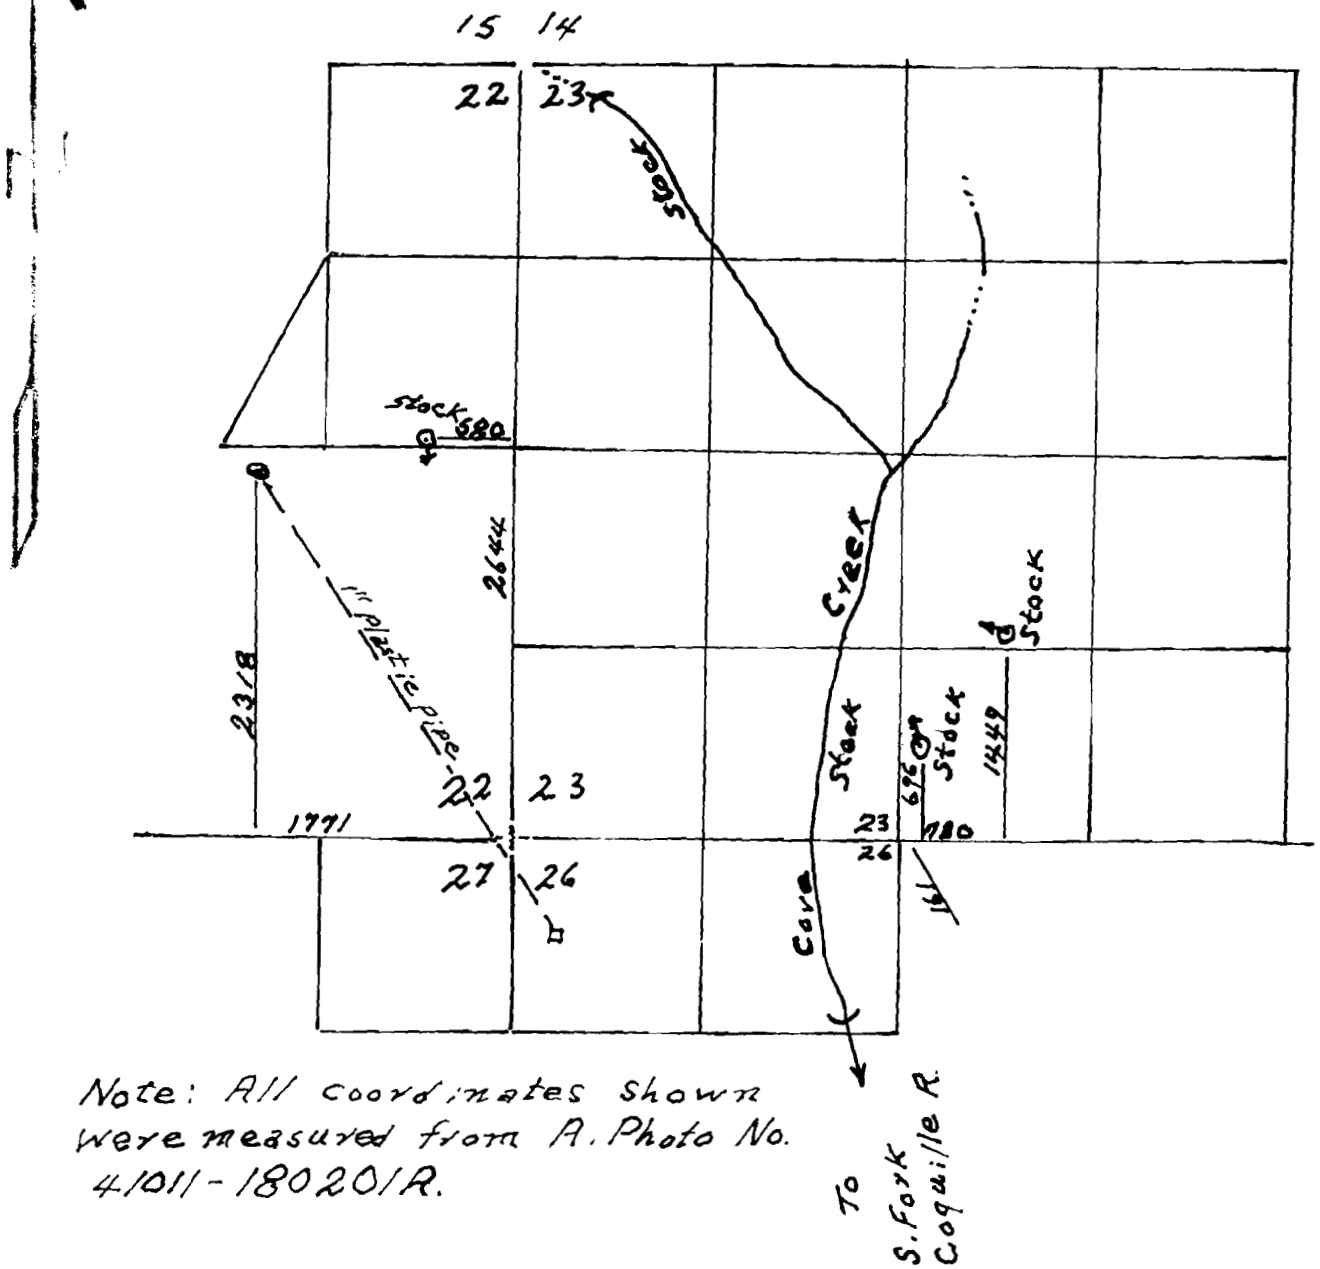

Note: All coordinates shown were measured from A. Photo No. 41011-180201R.