


RECEIVED

MAR - 5 1993

REGISTRATION STATEMENT MAP
PRE-1909 VESTED WATER RIGHT CLAIM
IN THE NAME OF HAYHURST RANCH

WATER RESOURCES DEPT.
SALEM, OREGON

SECTIONS 25 & 36, TOWNSHIP 22 SOUTH, RANGE 6 WEST, W.M.

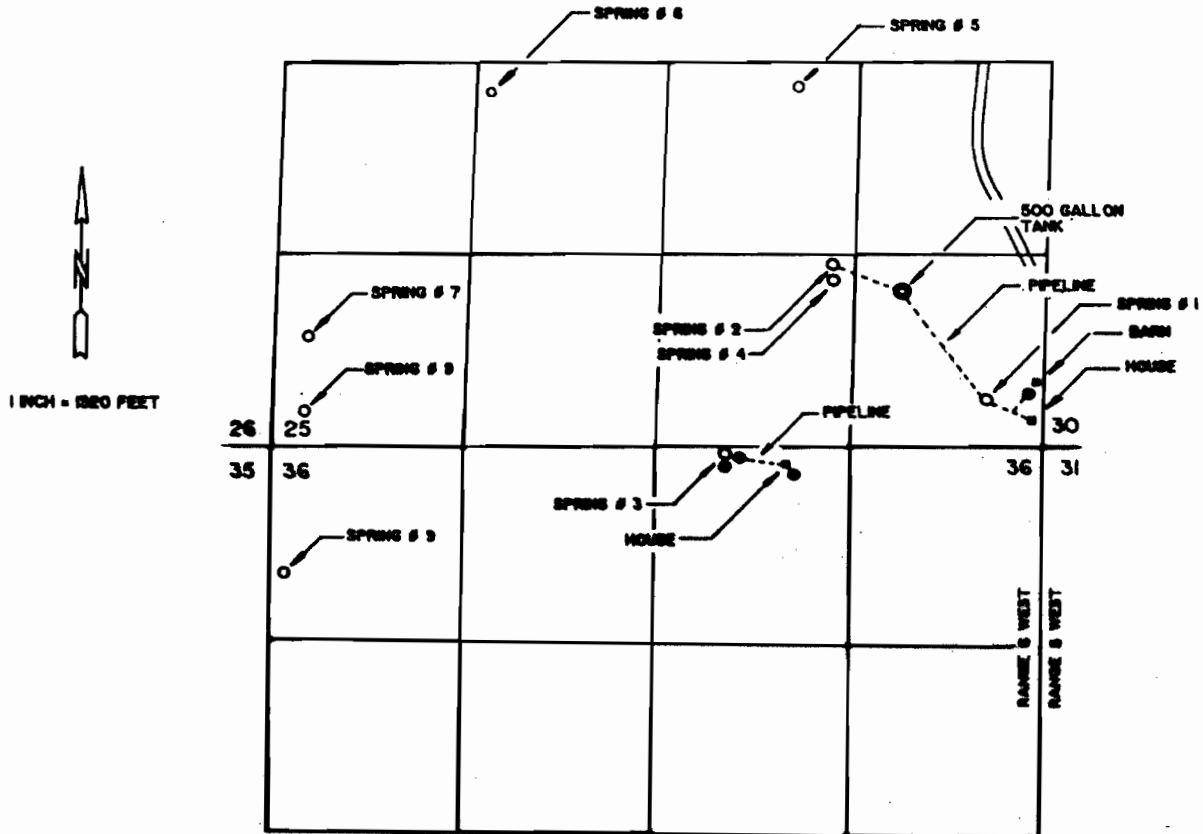

● STOCKWATER

| SOURCE | DISTANCE N/S | DISTANCE E/W | FROM | 1/4 1/4 |
|-----------|--------------|--------------|---------------|-----------------|
| SPRING #1 | 330 FT N | 390 FT WEST | SE COR SEC 25 | SE1/4 SE1/4 S25 |
| SPRING #2 | 1250 FT N | 1460 FT WEST | SE COR SEC 25 | SW1/4 SE1/4 S25 |
| SPRING #3 | 50 FT S | 2180 FT WEST | SE COR SEC 25 | NW1/4 NE1/4 S36 |

THE PURPOSE OF THIS MAP IS TO IDENTIFY THE LOCATION OF THE WATER RIGHT.
IT IS NOT INTENDED TO PROVIDE INFORMATION RELATIVE TO THE LOCATION OF
PROPERTY OWNERSHIP BOUNDARY LINES.

Certified Water Right Examiner
#054 WRE
James F. Gosson
James F. Gosson
Nov. 19, 1987
STATE OF OREGON