



SPRING No. 1 IS 850'S, 3450'E
 OF THE NW COR SEC 6 T 5N, R 44E, IN NW 1/4, NE 1/4
 SPRING No. 2 IS 450'S, 1000'E OF
 THE NW COR SEC 6 T 5N, R 44E, IN NW 1/4, NW 1/4
 SPRING No. 3 IS 2600'S, 1150'W OF
 THE NE COR SEC 1 T 5N, R 43E, IN SE 1/4, NE 1/4
 SPRING No. 4 IS 2550'S, 1600'E OF THE NW COR SEC 6
 T 5N, R 44E, IN SE 1/4, NW 1/4

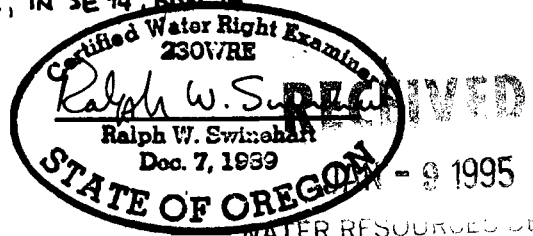

WATER RESOURCES DEPT
 SALEM, OREGON

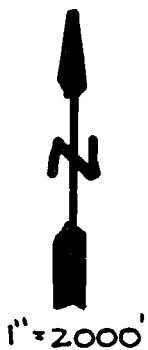

MAP BASED ON
 WALLOWA COUNTY
 ASSESSOR MAPS AND
 USGS ORTHOPHOTOQUADS

NOTE: THIS MAP IS PREPARED FOR
 WATER RIGHT PURPOSES ONLY AND
 SHOULD NOT BE USED FOR PROPERTY
 LINE LOCATION

SEC 1 T 5N R 43E &
 SEC 6 T 5N R 44E
 WALLOWA COUNTY

CANNON RANCH
 PRE 1909 WATER RIGHT APPL.