

T. 2 S. R. 2 E. W.M.

OREGON CITY, OR.


DECEMBER 22, 1992

IN THE SE. 1/4, N.W. 1/4 OF SEC. 31


FOR :

ATTACHMENT E

SMURFIT NEWSPRINT CORPORATION

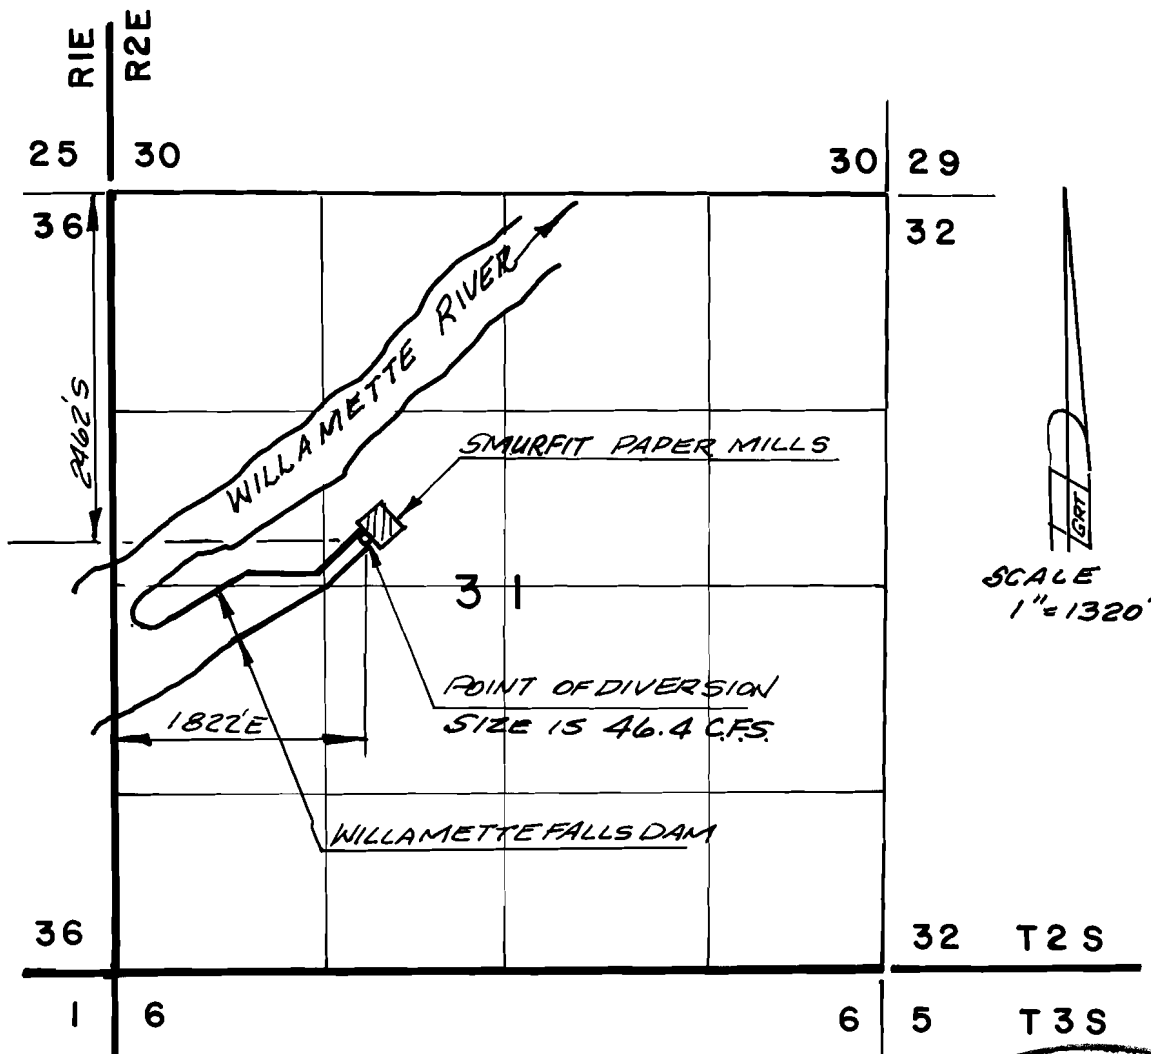

**FINAL PROOF SURVEY  
 UNDER  
 WILLAMETTE FALLS PROJECT  
 PRE-1909 VESTED WATER RIGHTS**

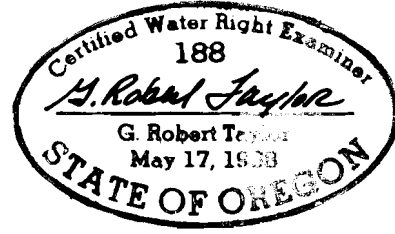

NOTE: THIS MAP WAS PREPARED FOR THE PURPOSE OF IDENTIFYING THE LOCATION OF WATER RIGHTS ONLY AND HAS NO INTENT TO PROVIDE DIMENSIONS OR LOCATION OF PROPERTY OWNERSHIP LINES.

CLACKAMAS COUNTY

PROJECT NO. 92-045  
COMSTOCK NORTHWEST, INC.