

MAP TO ACCOMPANY A SURFACE WATER REGISTRATION STATEMENT
 PRE 1909 VESTED WATER RIGHT CLAIM
 FOR COUNTY OF COOS, STATE OF OREGON

34233.0

DEC 21 1992



WATER RESOURCES DEPT
 SALEM, OREGON

DEC 31 1992
 WATER RESOURCES DEPT.
 SALEM, OREGON

T. 29 S. R. 12 W. W. M.

PREPARED FOR: Margaret E. Southmayd
 HC 86 Box 194
 Myrtle Point, OR 97458
 (503)396-4552

PREPARED BY: Prahar Surveying
 1045 Baltimore #1
 Bandon, OR 97411
 (503)347-9517

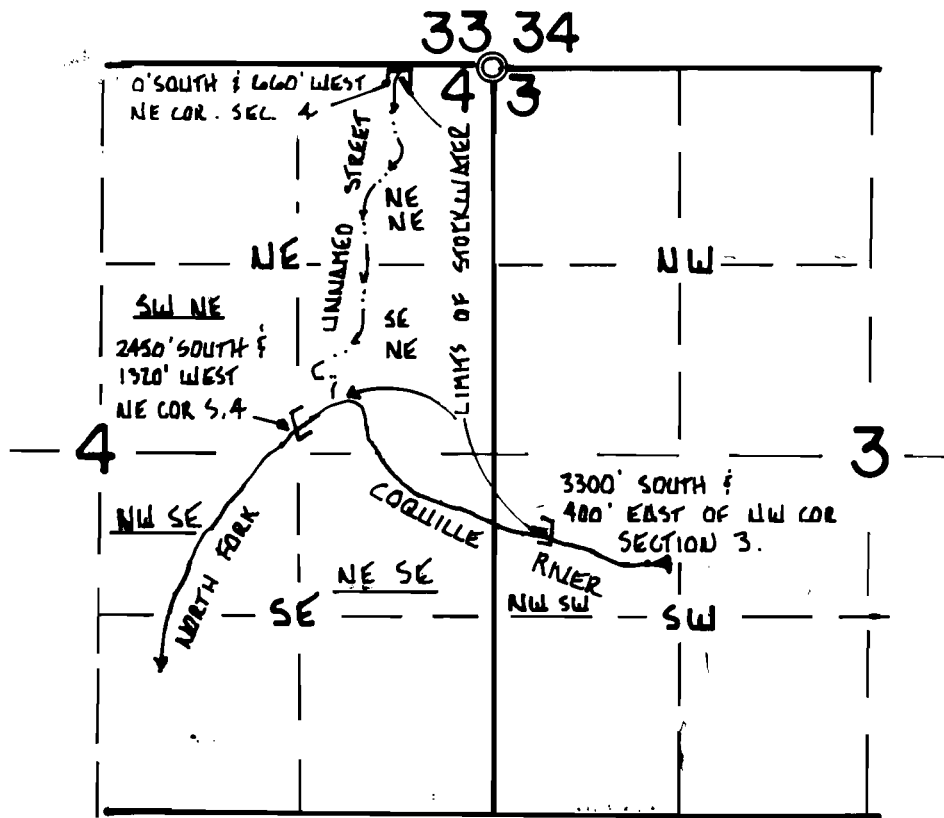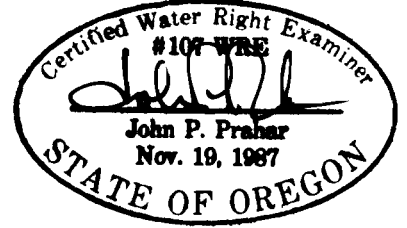

- LEGEND: Ⓞ NE corner of Section 4
 - - - - - unnamed stream
 North Fork Coquille River
 [] Limits of stockwatering

DATE: December 14, 1992

DISCLOSURE STATEMENT: This map was prepared for the sole purpose of locating a water right and is not intended to show ownership or property lines.