

T 17 S. R. 9 W. W. M.  
 SECTION 13 & 14  
 FINAL PROOF MAP CLAIM  
 OF BENEFICIAL USE  
 FOR  
**DOH WILBUR LTD.**  
 LAKE COUNTY, OREGON

JAN. 10, 1995



THIS MAP IS FOR WATER RIGHT  
 PURPOSE ONLY AND IS NOT  
 INTENDED TO PROVIDE  
 DIMENSIONS FOR LOCATING  
 PROPERTY BOUNDARIES

"A" - APPROXIMATE LOCATION  
 OF A 2" BURIED  
 MAINLINE

"B" - APPROXIMATE LOCATION  
 OF A 4" BURIED  
 MAINLINE.

DIVERSION POINT NO. 2

1720' SOUTH AND 70' WEST  
 OF THE N.E. COR. SEC. 14

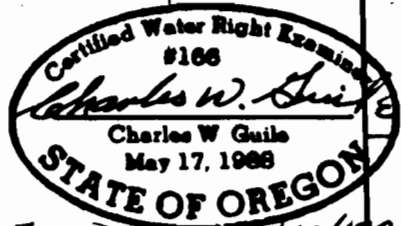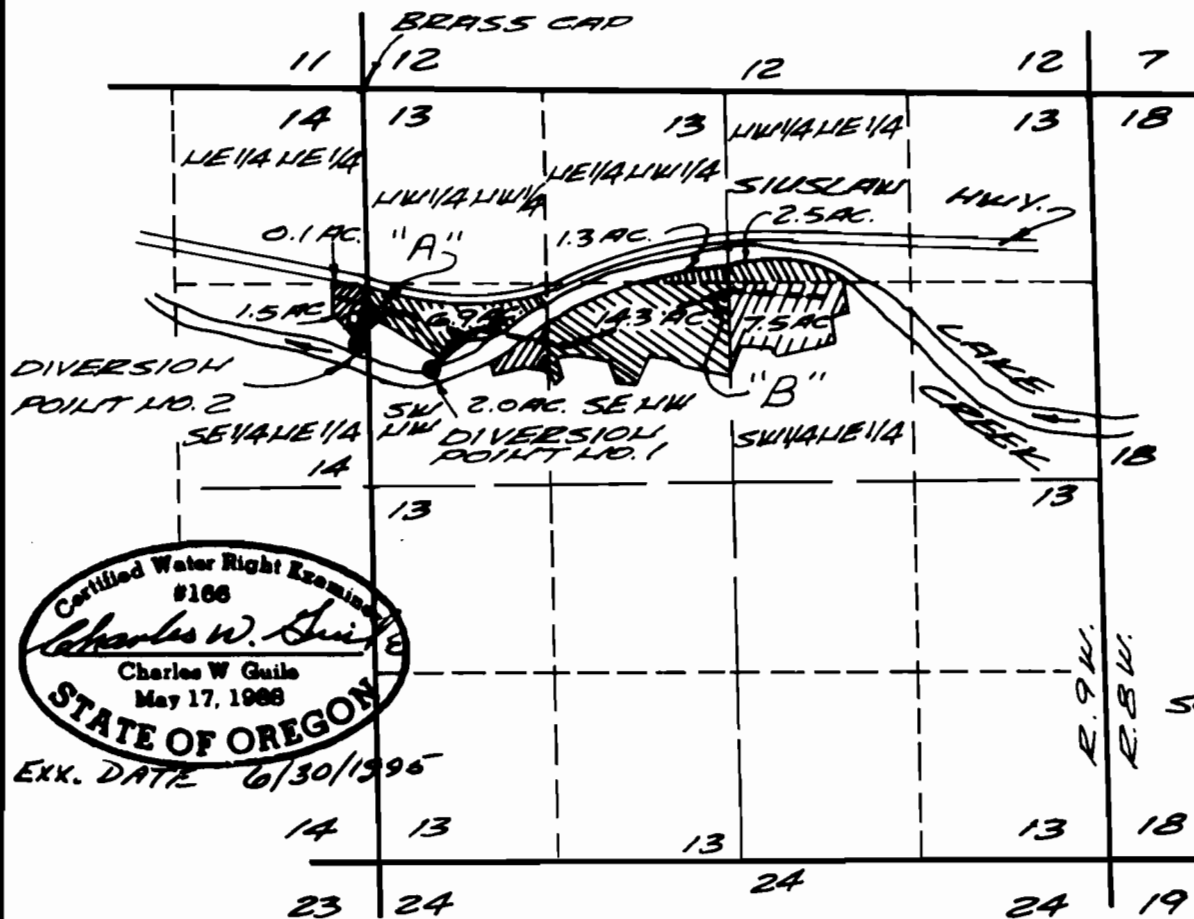

EXX. DATE 6/30/1995

FILE NO. SWR- 342  
 SURVEYED JUNE 4, 1992  
 BY: CHARLES W. GUILLE

DIVERSION POINT NO. 1  
 475' EAST AND 1955' SOUTH OF  
 THE N.W. COR. SEC. 13