


RECEIVED

NOV 04 1993

WATER RESOURCES  
DIVISION - OREGON

T 4 S, R 8 W, W M

TILLAMOOK COUNTY, OREGON

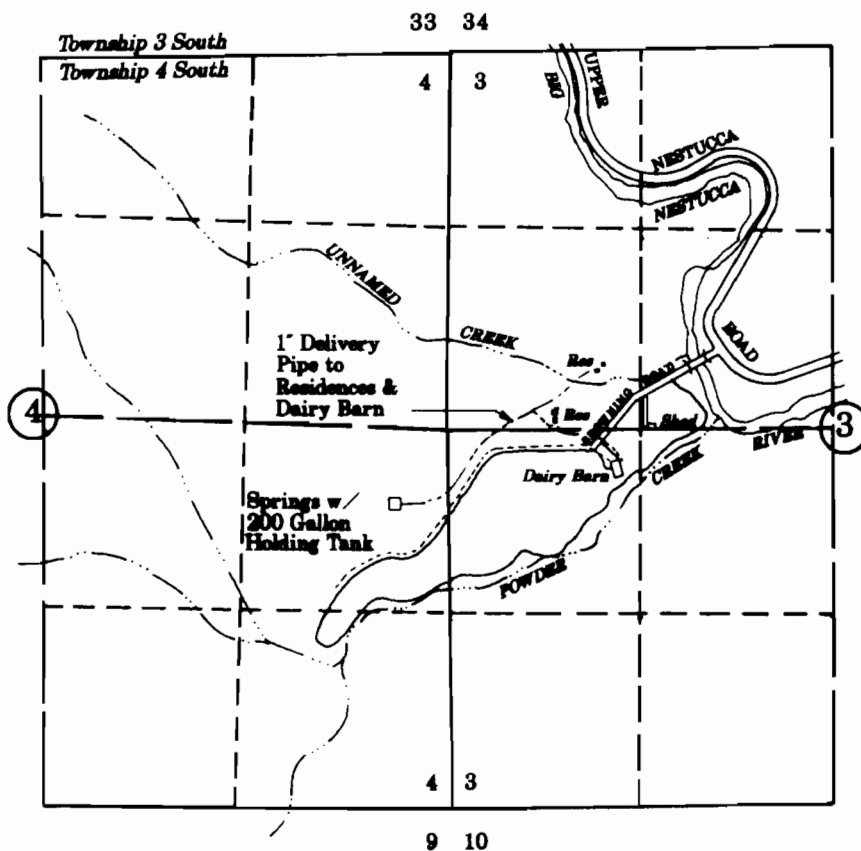

Div. Pt. : Springs are 510' South and 460' West of the NE Cor., NE 1/4, SE 1/4, Sec. 4  
 Spring Box is 510' South and 360' West of the NE Cor., NE 1/4, SE 1/4, Sec. 4

**SURFACE WATER REGISTRATION STATEMENT  
 PRE-1909 VESTED WATER RIGHT CLAIM**

**HILLARD C. HANSON**

December 28, 1992

Scale: 1" = 1320'

**NOTE:** This map is for the purpose of identifying the location of water rights and has no intent to dimension or locate property ownership lines.

