


T 18 S.R. 2 W.W.M.
SECTION 6
 FINAL PROOF MAP
 CLAIM OF BENEFICIAL USE
 FOR
EUGELIE V. & EMMA MURR
 LAKE COUNTY, OREGON


THIS MAP IS FOR WATER RIGHT PURPOSE ONLY AND IS NOT INTENDED TO PROVIDE DIMENSIONS FOR LOCATING PROPERTY BOUNDARIES

POINT OF DIVERSION

WELL IS 296 FEET SOUTH AND 119 FEET WEST OF THE S.E. COR. D.L.C. NO. 66

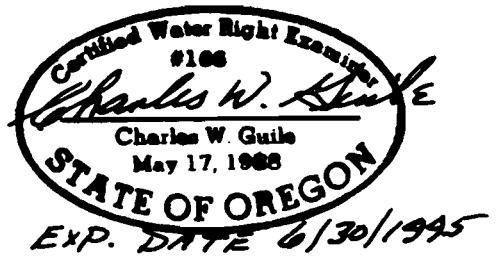

CHARLES W. GUILE
 & ASSOCIATES, CO.
 Land Surveying
 52 Centennial Loop
 Eugene, OR 97401

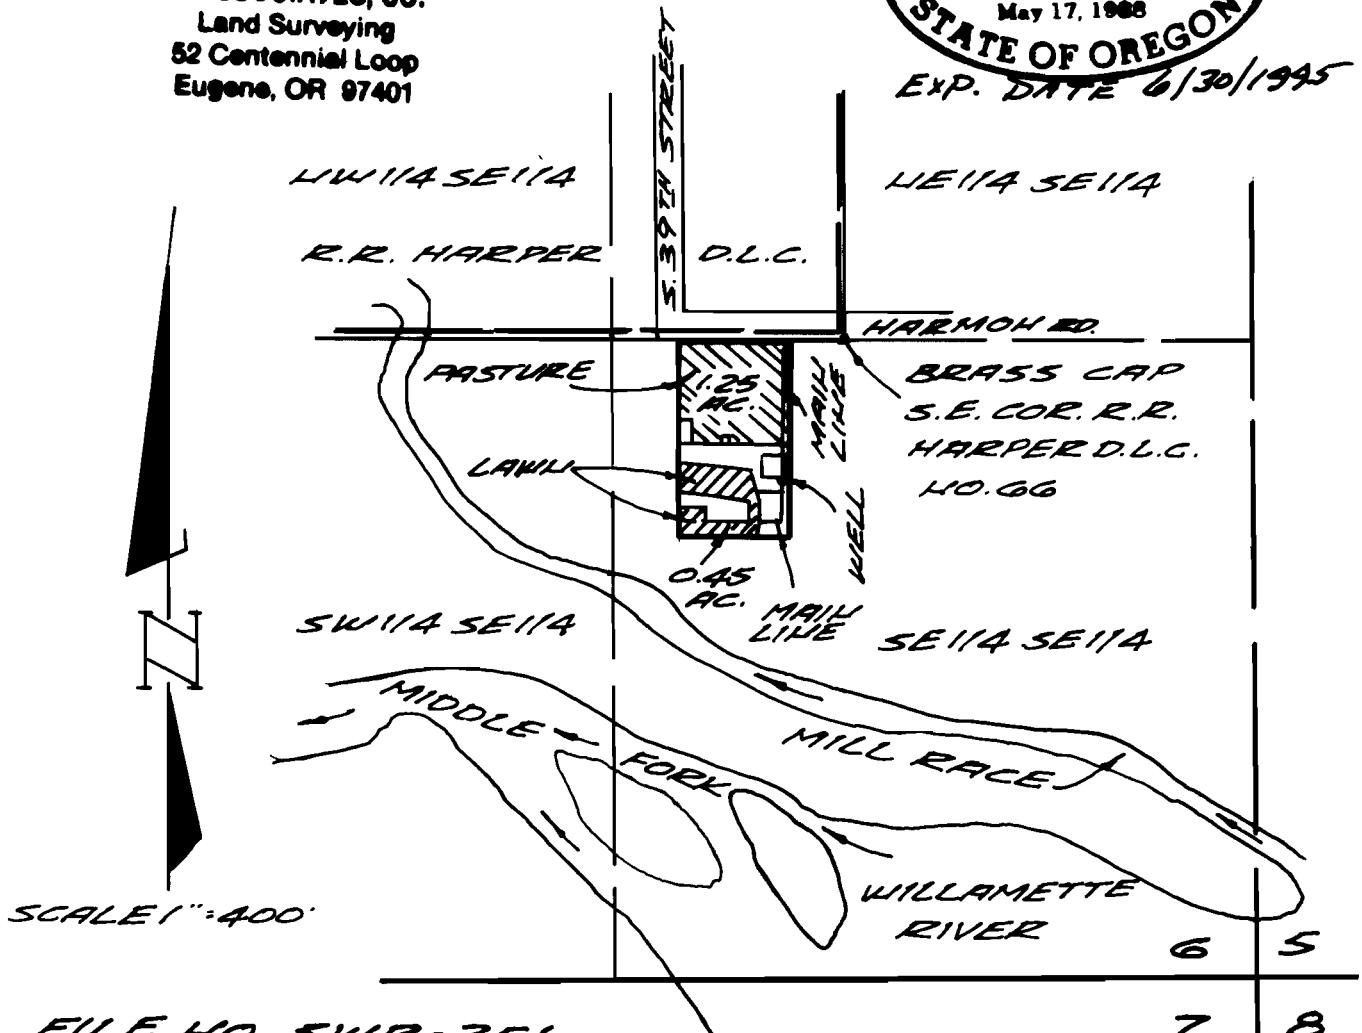

92-88