


**CLAIM OF BENEFICIAL USE MAP  
HARRY & VICTORIA DAVIS**

File No. SWR-356  
SECTIONS 12, 13, T24S, R12W, W.M.

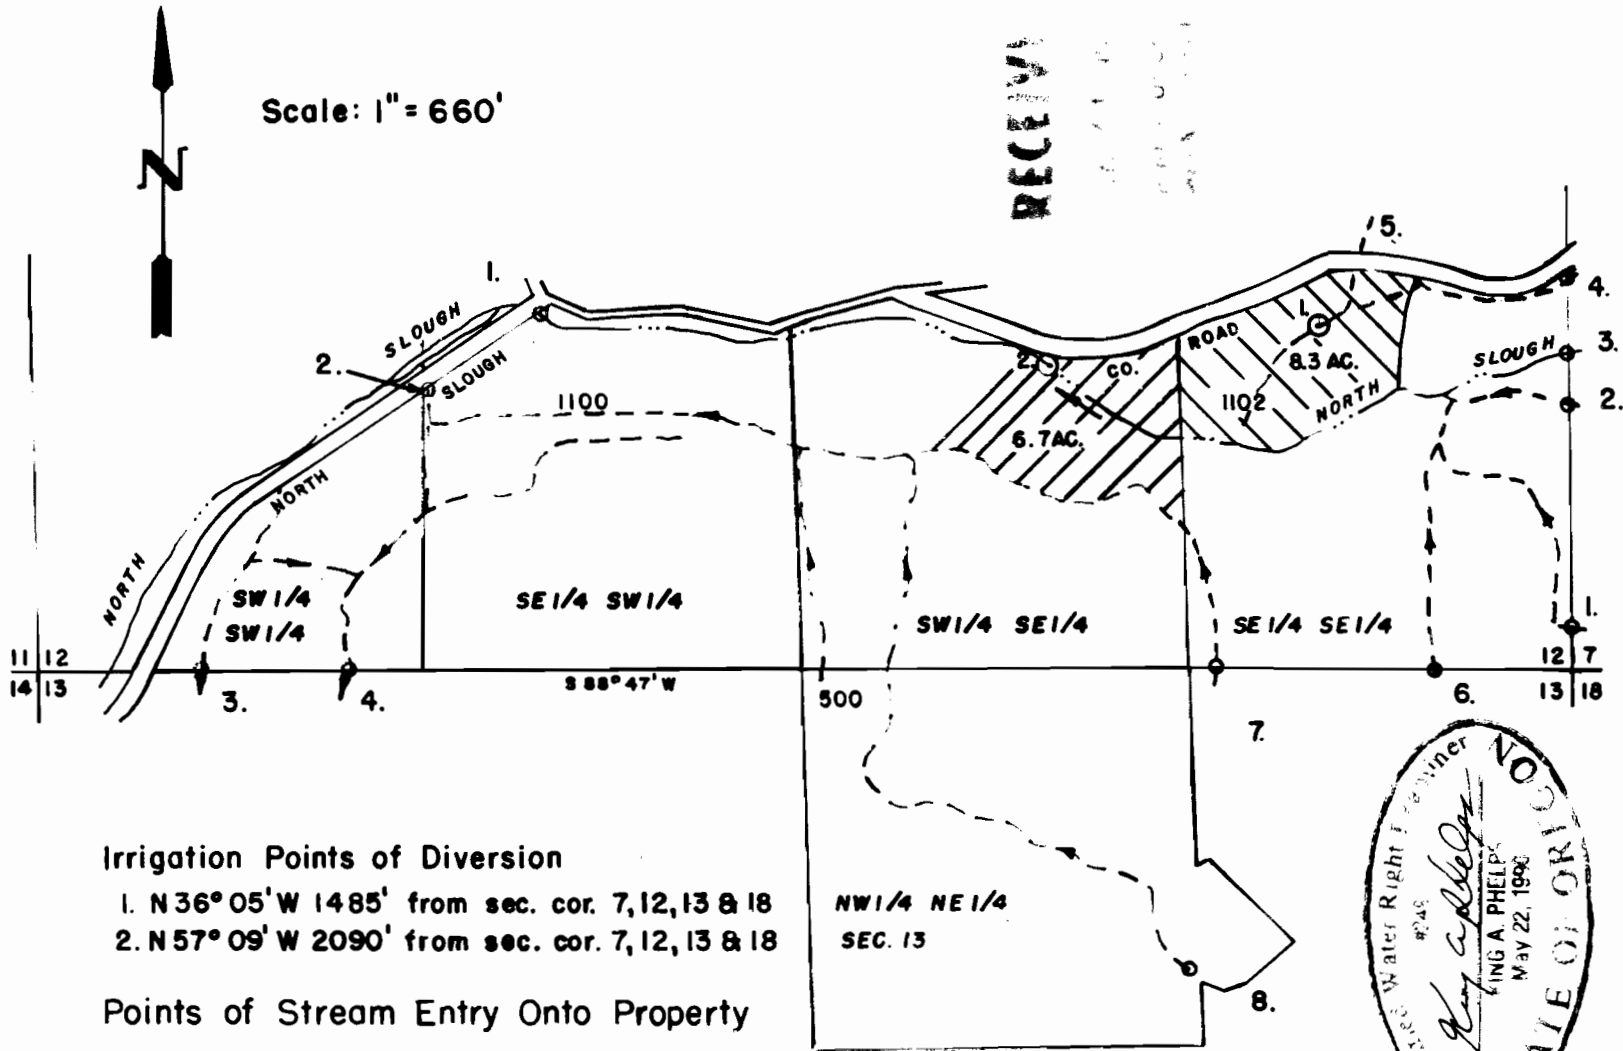

**Irrigation Points of Diversion**

1. N 36° 05' W 1485' from sec. cor. 7, 12, 13 & 18
2. N 57° 09' W 2090' from sec. cor. 7, 12, 13 & 18

**Points of Stream Entry Onto Property**

1. N 150' from the section corner 7, 12, 13 & 18.
2. N 856' from the section corner 7, 12, 13 & 18.
3. N 1116' from the section corner 7, 12, 13 & 18.
4. N 1360' from the section corner 7, 12, 13 & 18.
5. N 24° 4' W, 1584' from section corner 7, 12, 13 & 18.
6. N 88° 47' W, 450' from section corner 7, 12, 13 & 18.
7. N 88° 47' W, 1205' from section corner 7, 12, 13 & 18
8. S 50° 04' W, 1692' from section corner 7, 12, 13 & 18

**Points of Stream Exit From Property**

1. S 88° 15' E, 1741' from the section corner 11, 12, 13 & 14.
2. S 74° 29' E, 1329' from the section corner 11, 12, 13 & 14.
3. S 88° 47' E, 508' from the section corner 11, 12, 13 & 14.
4. S 88° 47' E, 1045' from the section corner 11, 12, 13 & 14.

THE PURPOSE OF THIS MAP IS TO IDENTIFY THE LOCATION OF THE WATER RIGHT. IT IS NOT INTENDED TO PROVIDE INFORMATION RELATIVE TO THE LOCATION OF PROPERTY OWNERSHIP BOUNDARY LINES.