


# T. 28 S., R.13 W.W.M.

SWR-357

SECTIONS 19 AND 30

THIS MAP IS FOR THE PURPOSE OF LOCATING THE WATER RIGHT ONLY AND IS NOT INTENDED TO PROVIDE LEGAL DIMENSIONS OR LOCATIONS OF PROPERTY OWNERSHIP LINES.

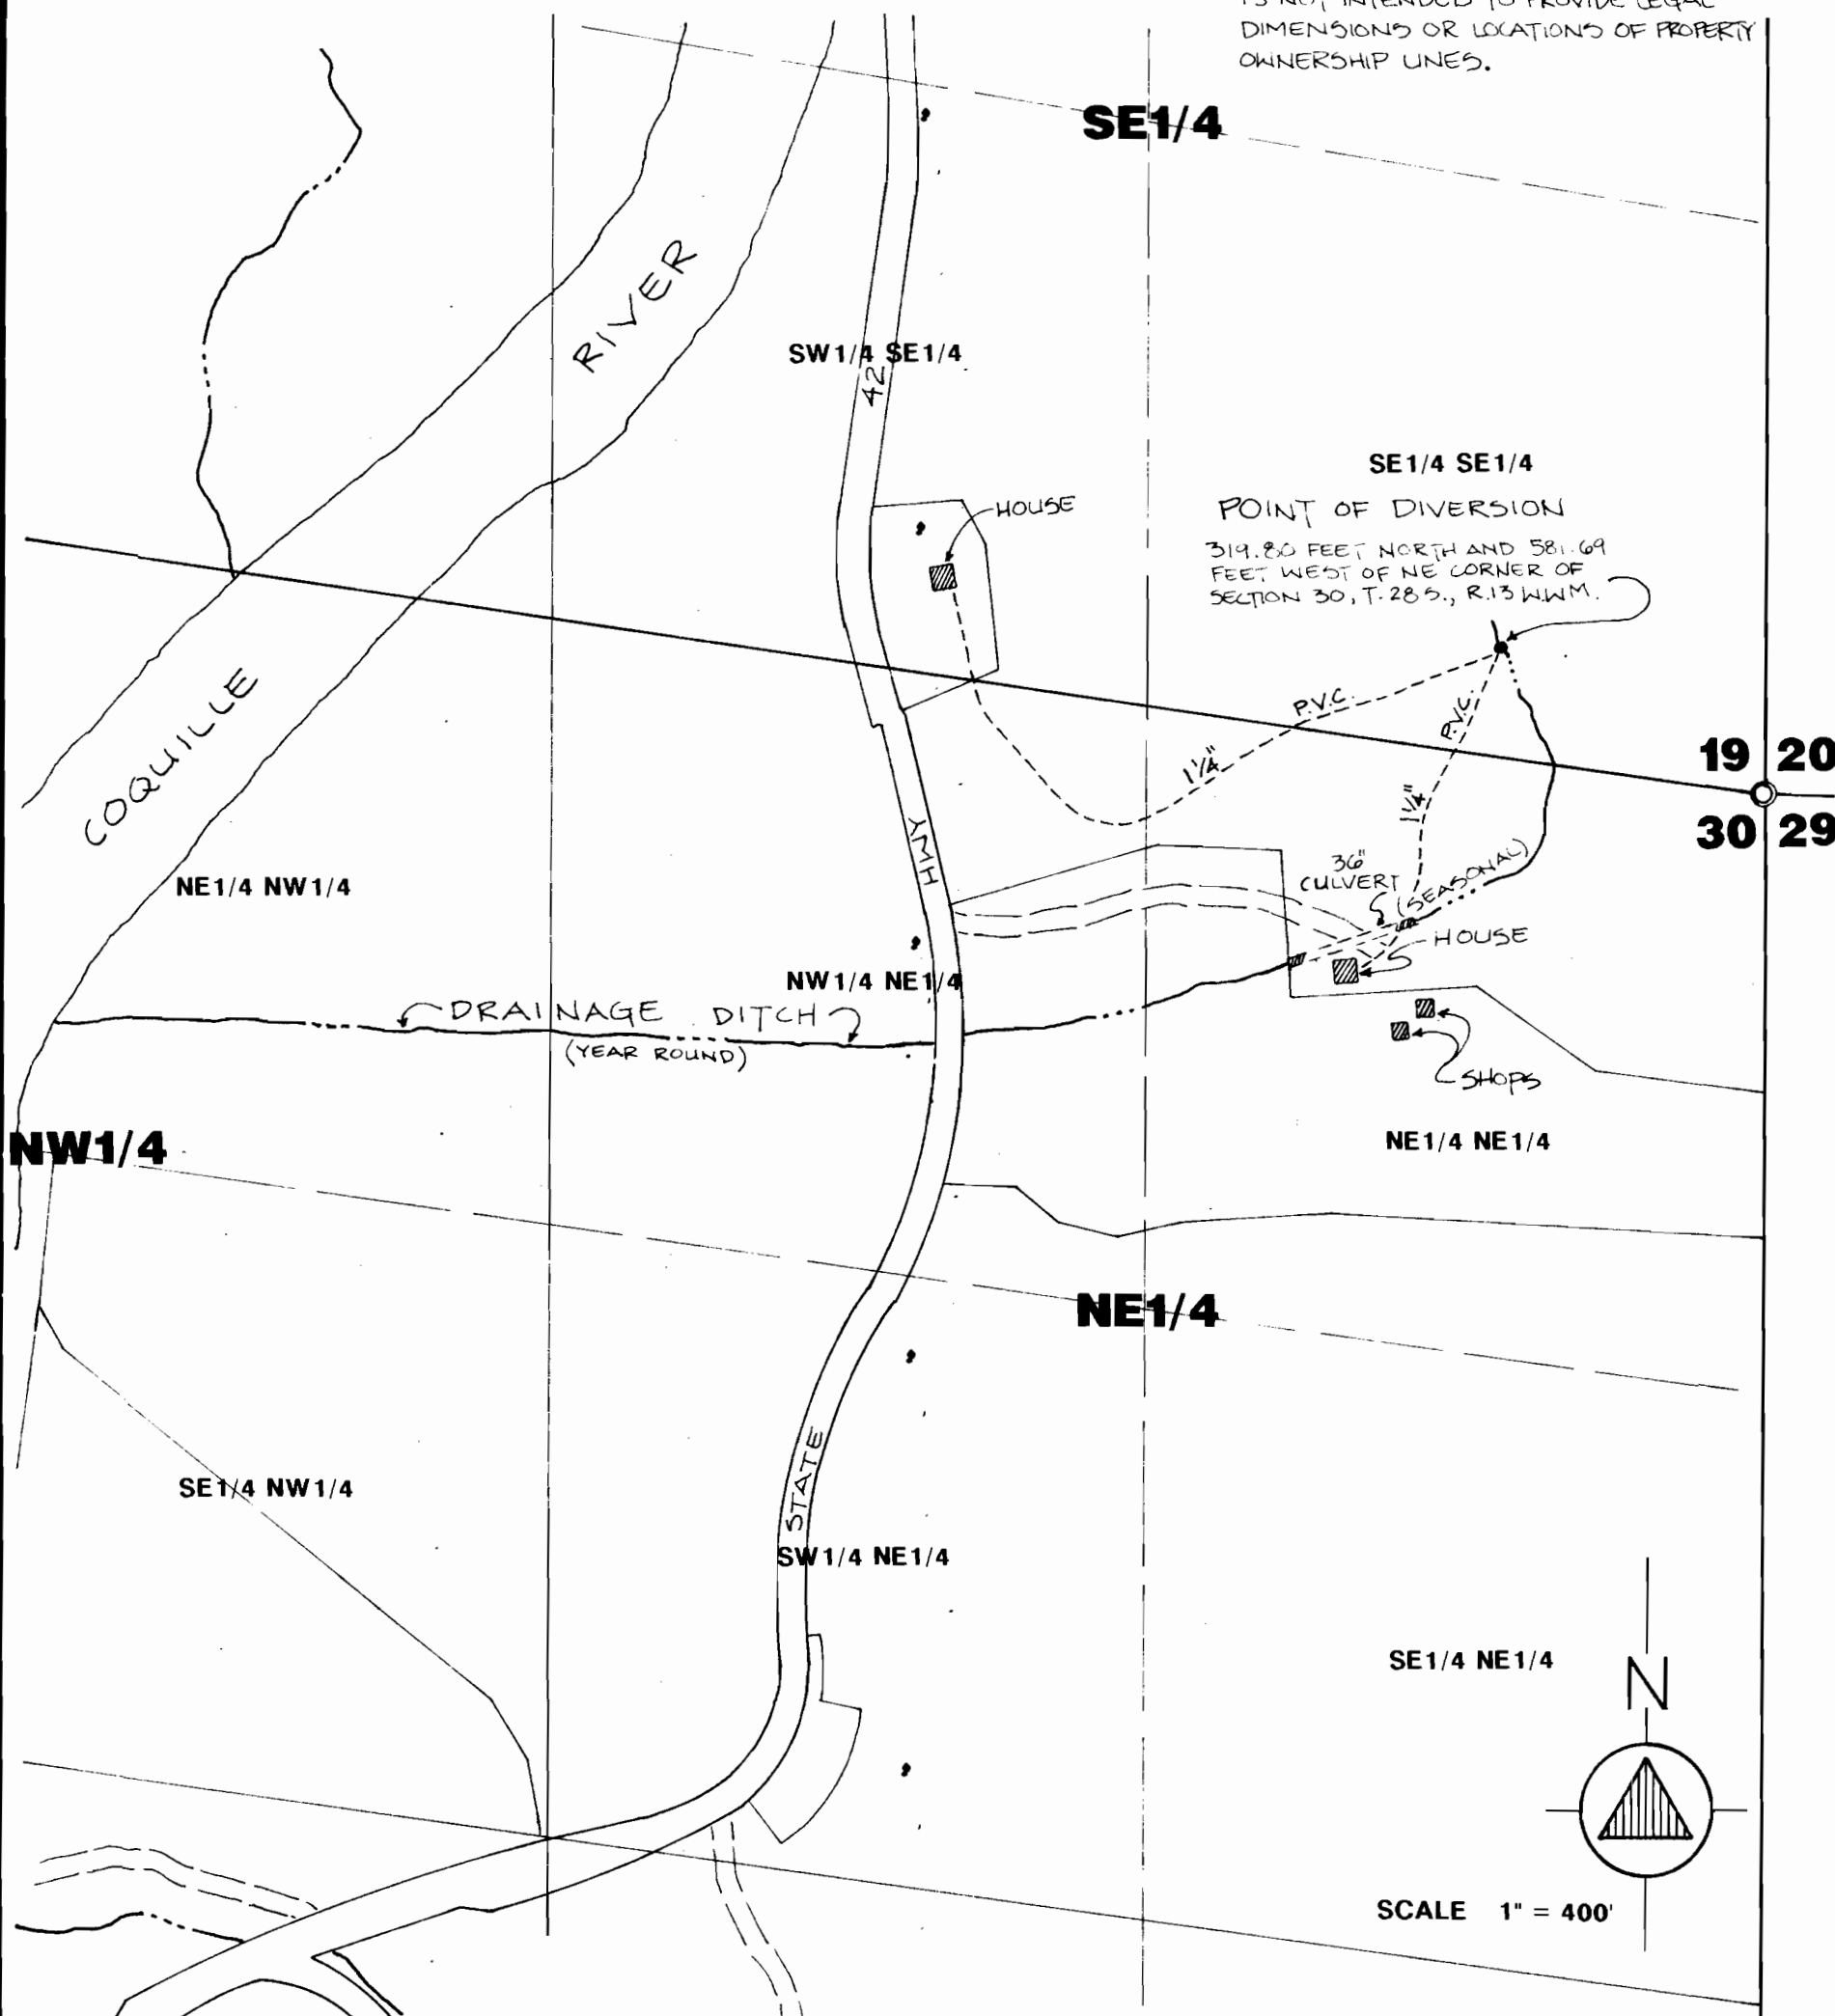

## WATER RIGHTS MAP

S1/2 SE1/4 SECTION 19 AND, NE1/4 NW1/4, SE1/4 NW1/4,  
N1/2 NE1/4, SW1/4 NE1/4 SECTION 30, T 28 S, R13 WWM  
for CRAIG W. TRESIDDER

SURVEYED 5-3-93 & 11-4-93.

Edward W. Riley  
ENGINEER  
1015 BEND, OREGON 97109

