


SPRING #1 IS LOCATED 430' N AND 915' E OF THE SW CORNER OF SEC. 35. IT CONSISTS OF A ROCK CISTERN ABOUT 3 1/2' IN DIAMETER, WITH A 5' SQUARE PUMP HOUSE BUILT OVER IT.

SPRING #2 IS LOCATED 370' N AND 940' E OF THE SW CORNER OF SEC. 35. IT CONSISTS OF A ROCK AND BRICK CISTERN CONSTRUCTED OVER A SPRING, WITH A PIPE CONNECTING IT TO THE CISTERN OF SPRING #1.

THE PUMP HOUSE CONTAINS A 12 VOLT BATTERY OPERATED PUMP RATED AT 2.8 GPM AT 40PSI. THE PUMP SUPPLIES DOMESTIC WATER TO THE HOUSE. THE GARDEN IS IRRIGATED WITH TEMPORARY PIPING IN THE SUMMER.

MAP BASED ON ASCS AERIAL PHOTO AND SITE INSPECTION MADE ON 11/10/93

THIS MAP IS PREPARED FOR WATER RIGHT PURPOSES ONLY AND SHOULD NOT BE USED FOR PROPERTY LOCATION PURPOSES.

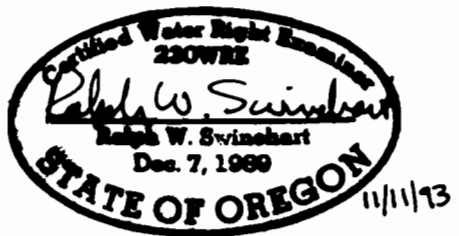

IN SECTION 35, T5N, R42E, WM
WALLOWA COUNTY

PRE 1909 WATER RIGHT APP. MAP
FOR: KENNETH AND IRENE BARKLOW