


PRE-190⁰ VESTED WATER RIGHT

Area of use located in the NE 1/4 SW 1/4, SE 1/4 SW 1/4 of Sec. 2 and the NE 1/4 NW 1/4 of Sec. 11 Township 28 S. Range 10 W. W.M., Coos County, Oregon
SWR - 363

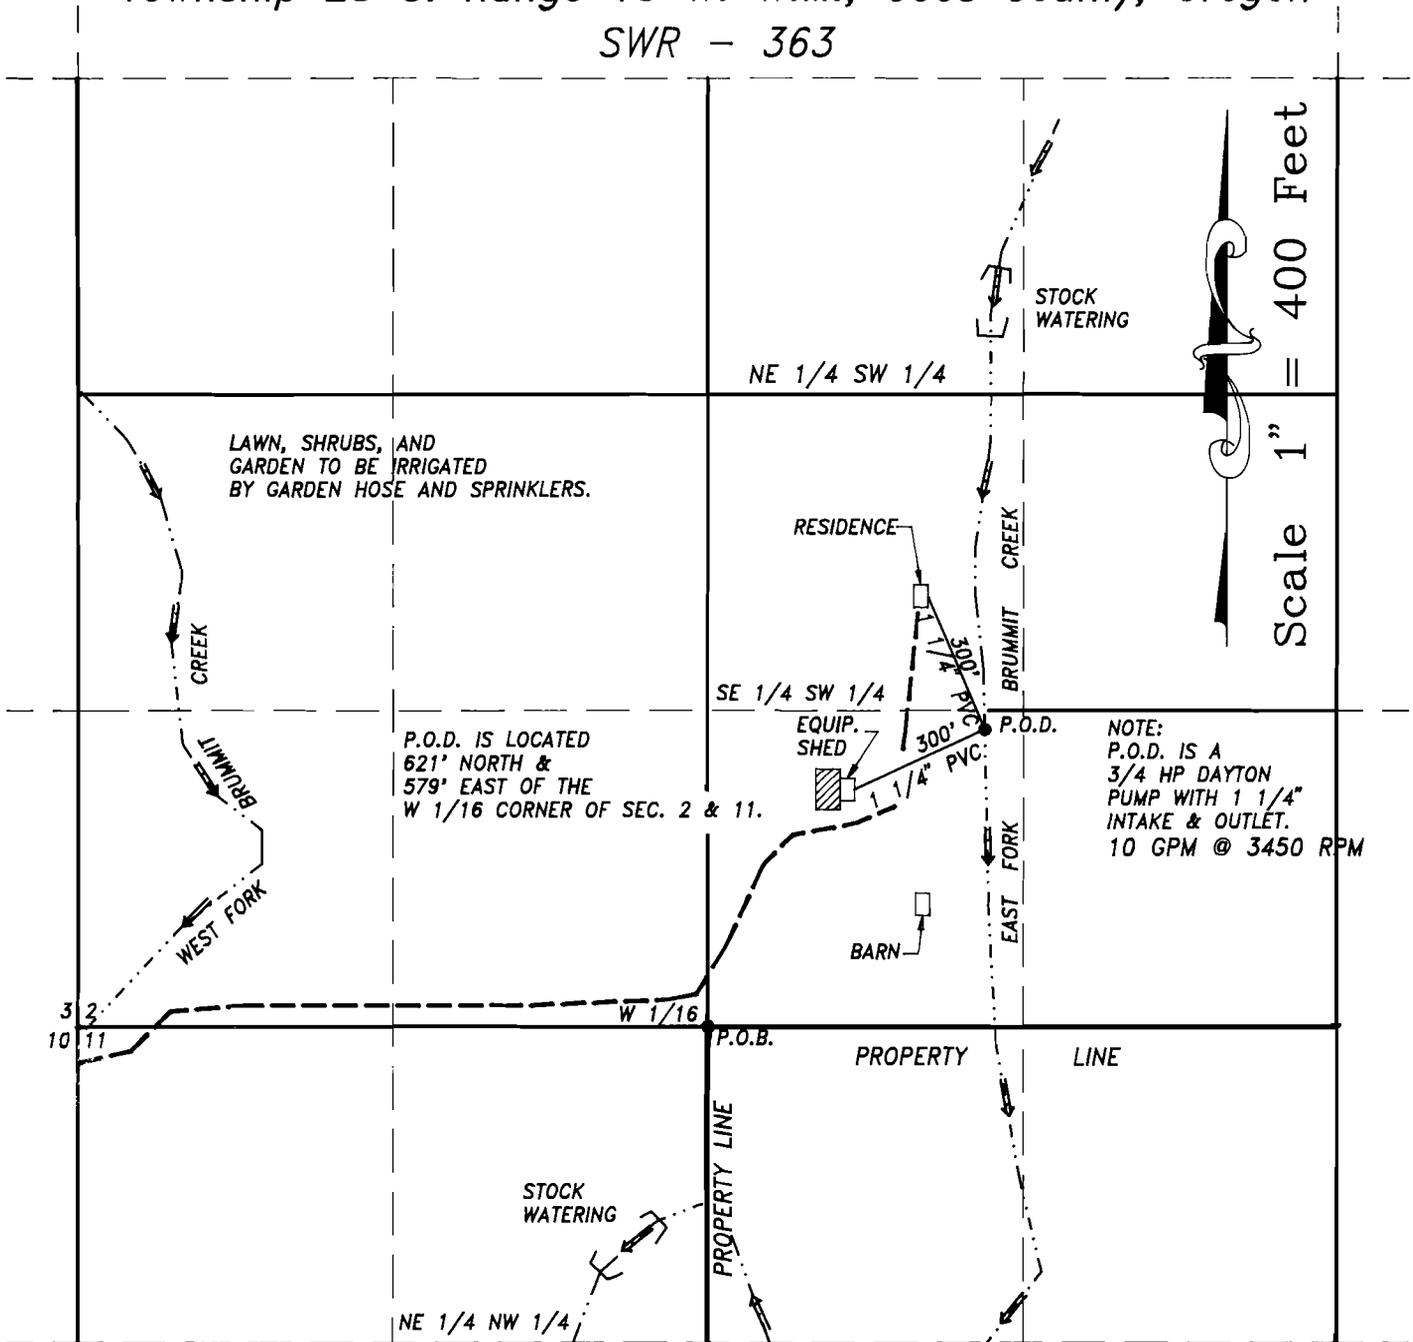

Scale 1" = 400 Feet

NOTE:
P.O.D. IS A
3/4 HP DAYTON
PUMP WITH 1 1/4"
INTAKE & OUTLET.
10 GPM @ 3450 RPM



Prepared for Harold M. Hancock
Surveyed by Dennis Goude
Surveyed on 11-16-93
APPLICATION #
PERMIT #

LEGEND

- P.O.D (POINT OF DIVERSION)
- P.O.B. (POINT OF BEGINNING)
- ↔ IN-STREAM STOCK WATERING
- ▨ IRRIGATED AREA (0.1 AC.)
- - - ROAD
- CREEK
- PROPERTY LINE

EXAMINERS DISCLAIMER STATEMENT

The preparation of this map was for the purpose of identifying the location of the Water Right only and has no intent to provide dimensions or location of property ownership lines.