

# CLAIM OF BENEFICIAL USE MAP


FOR

DEE MOREY

SWR-376

Sections 11, 14 T28S, R12WWM

TAX LOTS 200,400

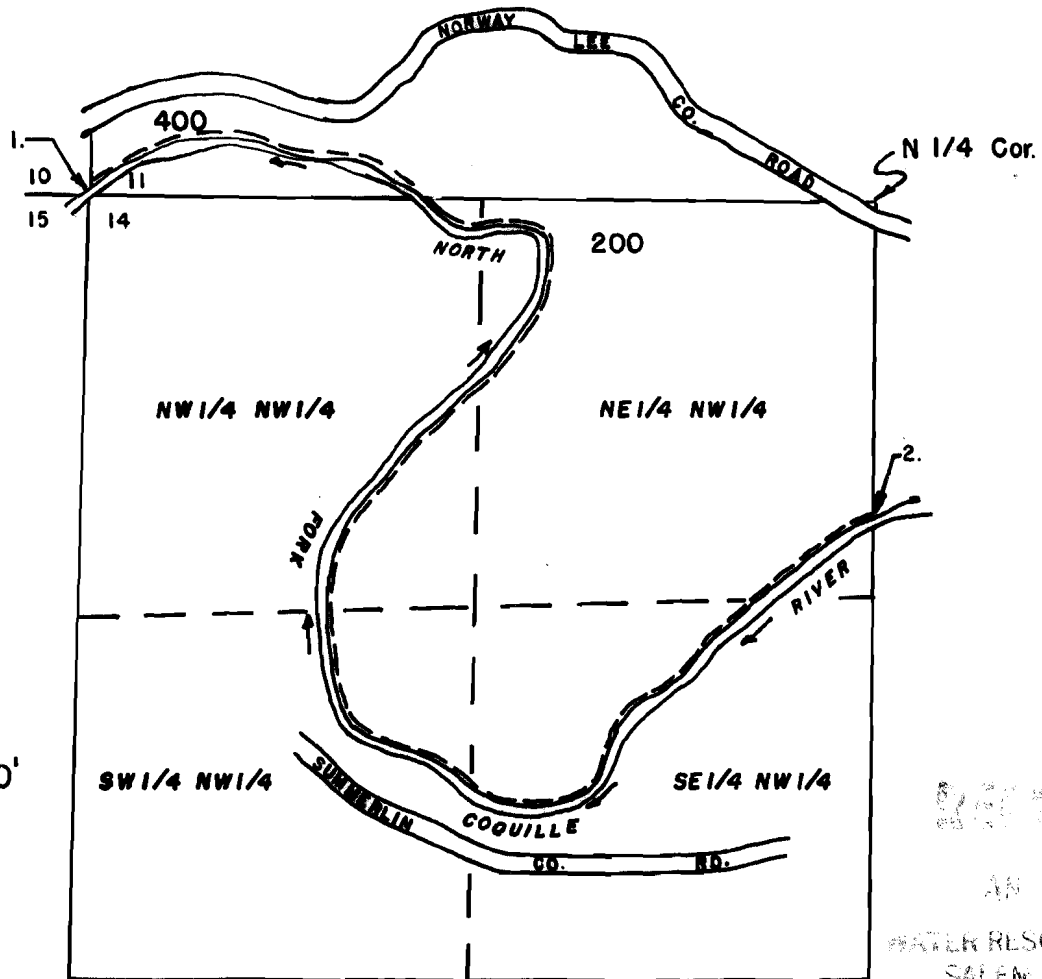


Scale: 1" = 660'

STATE OF OREGON  
 WATER RESOURCES DEPT  
 SALEM, OREGON

1. Point of stream entry is located 990' south of the N1/4 corner, Sec. 14.

2. Point of stream exit is located N89° 26' W a distance of 2634' from the N1/4 corner, Sec. 14.

--- Reach of stream used for livestock watering

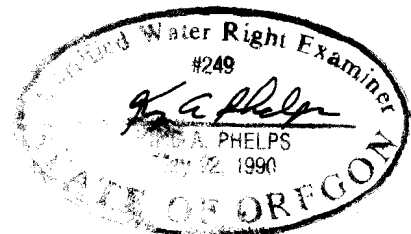

THE PURPOSE OF THIS MAP IS TO IDENTIFY THE LOCATION OF THE WATER RIGHT. IT IS NOT INTENDED TO PROVIDE INFORMATION RELATIVE TO THE LOCATION OF PROPERTY OWNERSHIP BOUNDARY LINES.