


T30S R5W WM
SECTION 34

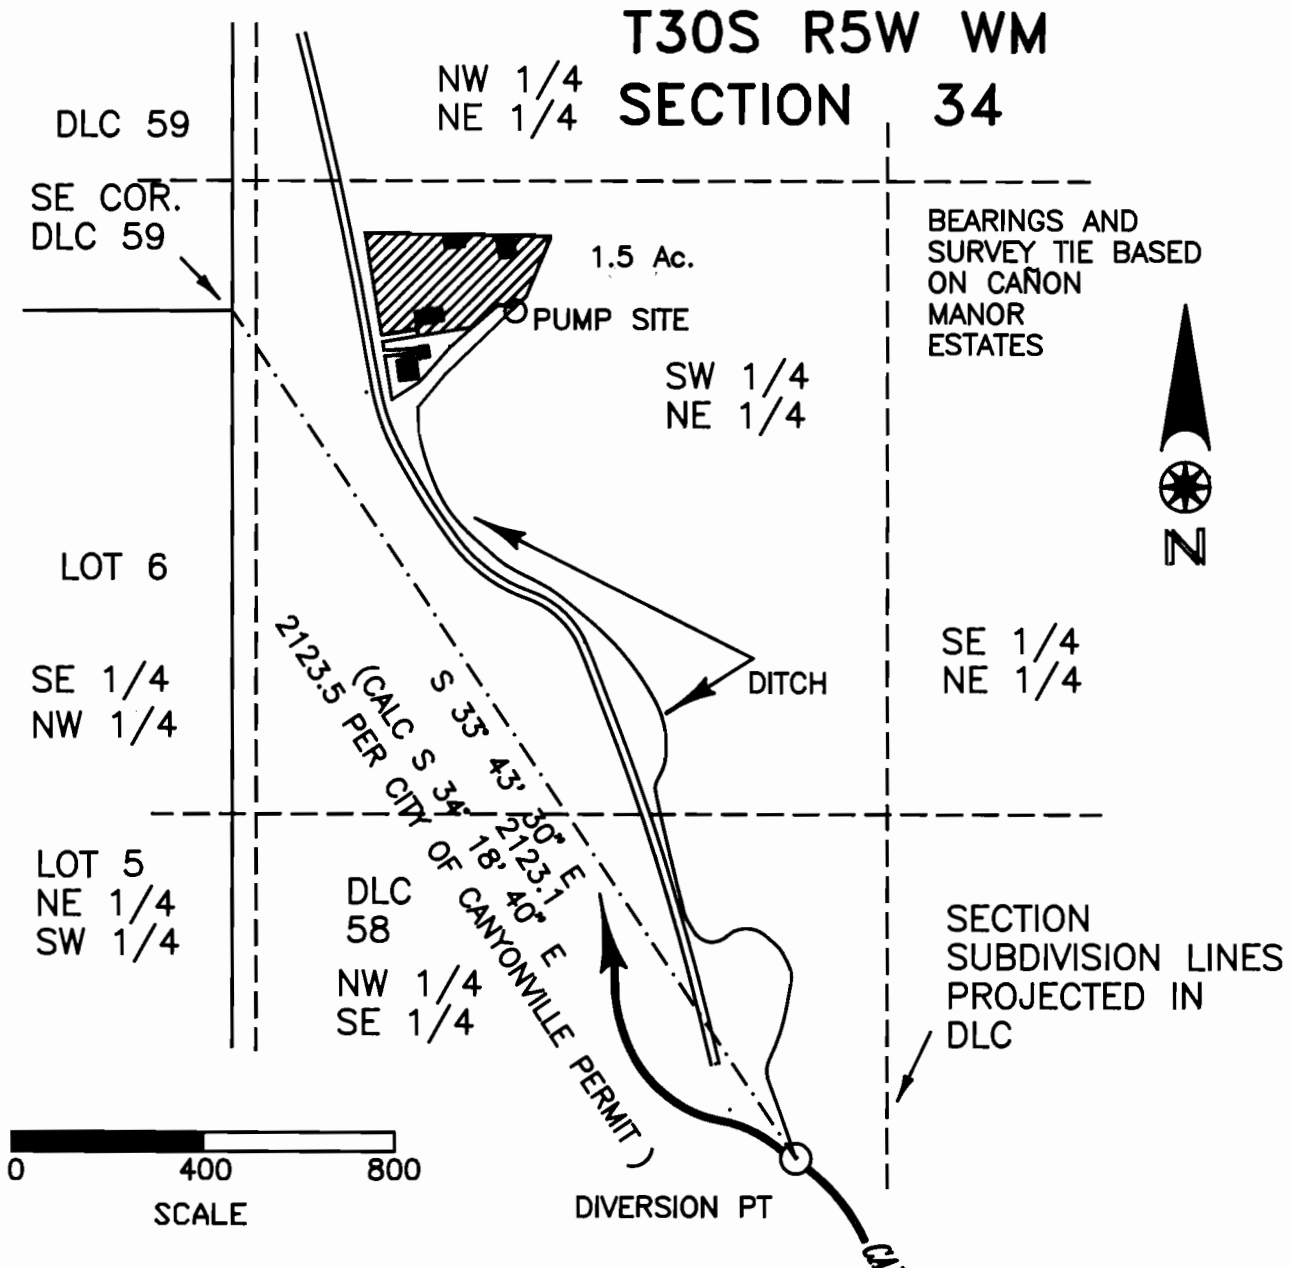

**SURVEY OF CLAIM FOR
VESTED WATER RIGHT
IN NAME OF JOHN AND JEAN BERRY**

DATE JANUARY 1990
BY: WILLIAM J. RUPPERT
P.O. BOX 1564
MYRTLE CREEK, OR 97457

