
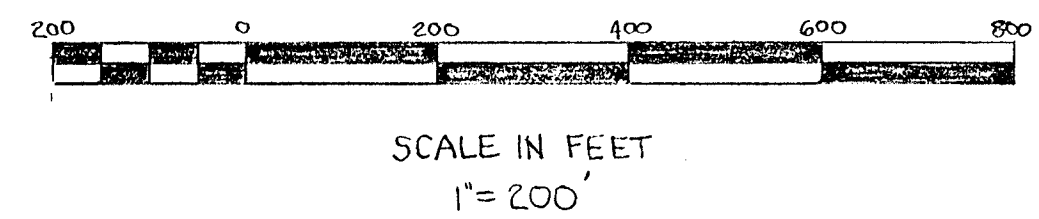


REFERENCE DRAWINGS

- FERC OAK GROVE PROJECT LICENSE DRAWINGS
 EXHIBIT L, SHT. 2 OF 19
 EXHIBIT L, SHT. 3 OF 19
 EXHIBIT L, SHT. 4 OF 19
 EXHIBIT L, SHT. 9 OF 19
 EXHIBIT L, SHT. 11 OF 19
 EXHIBIT L, SHT. 12 OF 19
 EXHIBIT L, SHT. 16 OF 19
 EXHIBIT K, SHT. 11 OF 18

NOTE:
 WORK THIS DRAWING WITH DRAWING C-20442.

THE PURPOSE OF THIS MAP IS TO IDENTIFY THE LOCATION OF WATER RIGHTS. IT IS NOT INTENDED TO PROVIDE INFORMATION RELATIVE TO THE LOCATION OF PROPERTY OWNERSHIP BOUNDARY LINES.


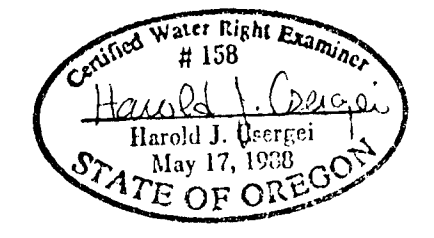


T.5S., R.6E., W.M.


← TO ESTACADA

THIS FINAL PROOF SURVEY WAS PERFORMED DURING THE PERIOD OCTOBER-DECEMBER, 1992.


REV	DATE	DESCRIPTION	BY	ENGR	SUPV	APPD
REVISIONS						
PORTLAND GENERAL ELECTRIC CO. PORTLAND, OREGON						
OAK GROVE PROJECT THREE LYNX CREEK PRE 1909 VESTED WATER RIGHTS FINAL PROOF SURVEY						
APPROVALS		DATE	SCALE			
DRAWN BY H.J.C.		12/28/92	1"=200'			
ENGINEER		DRAWING NO.	REV.			
SUPV		D-10519				

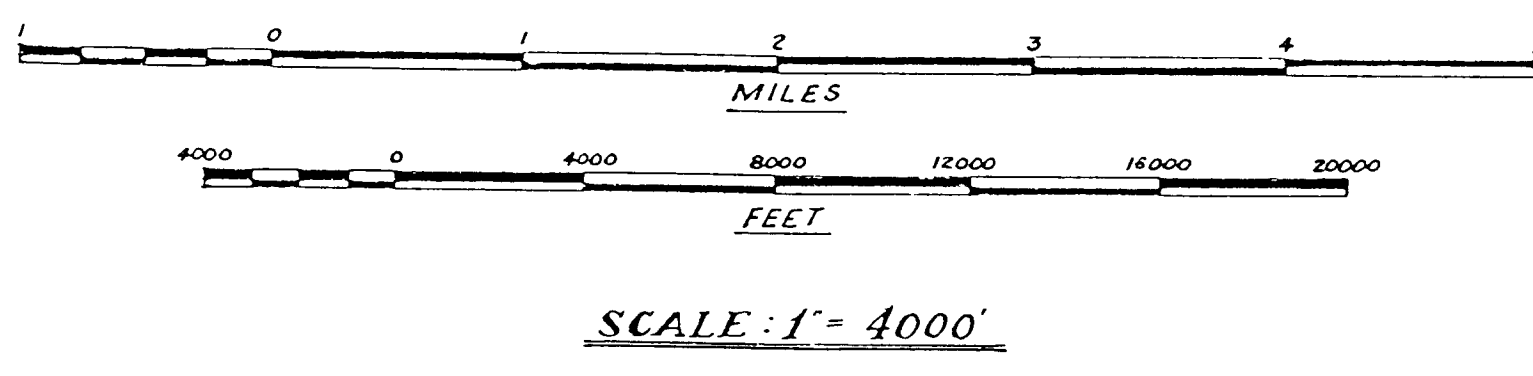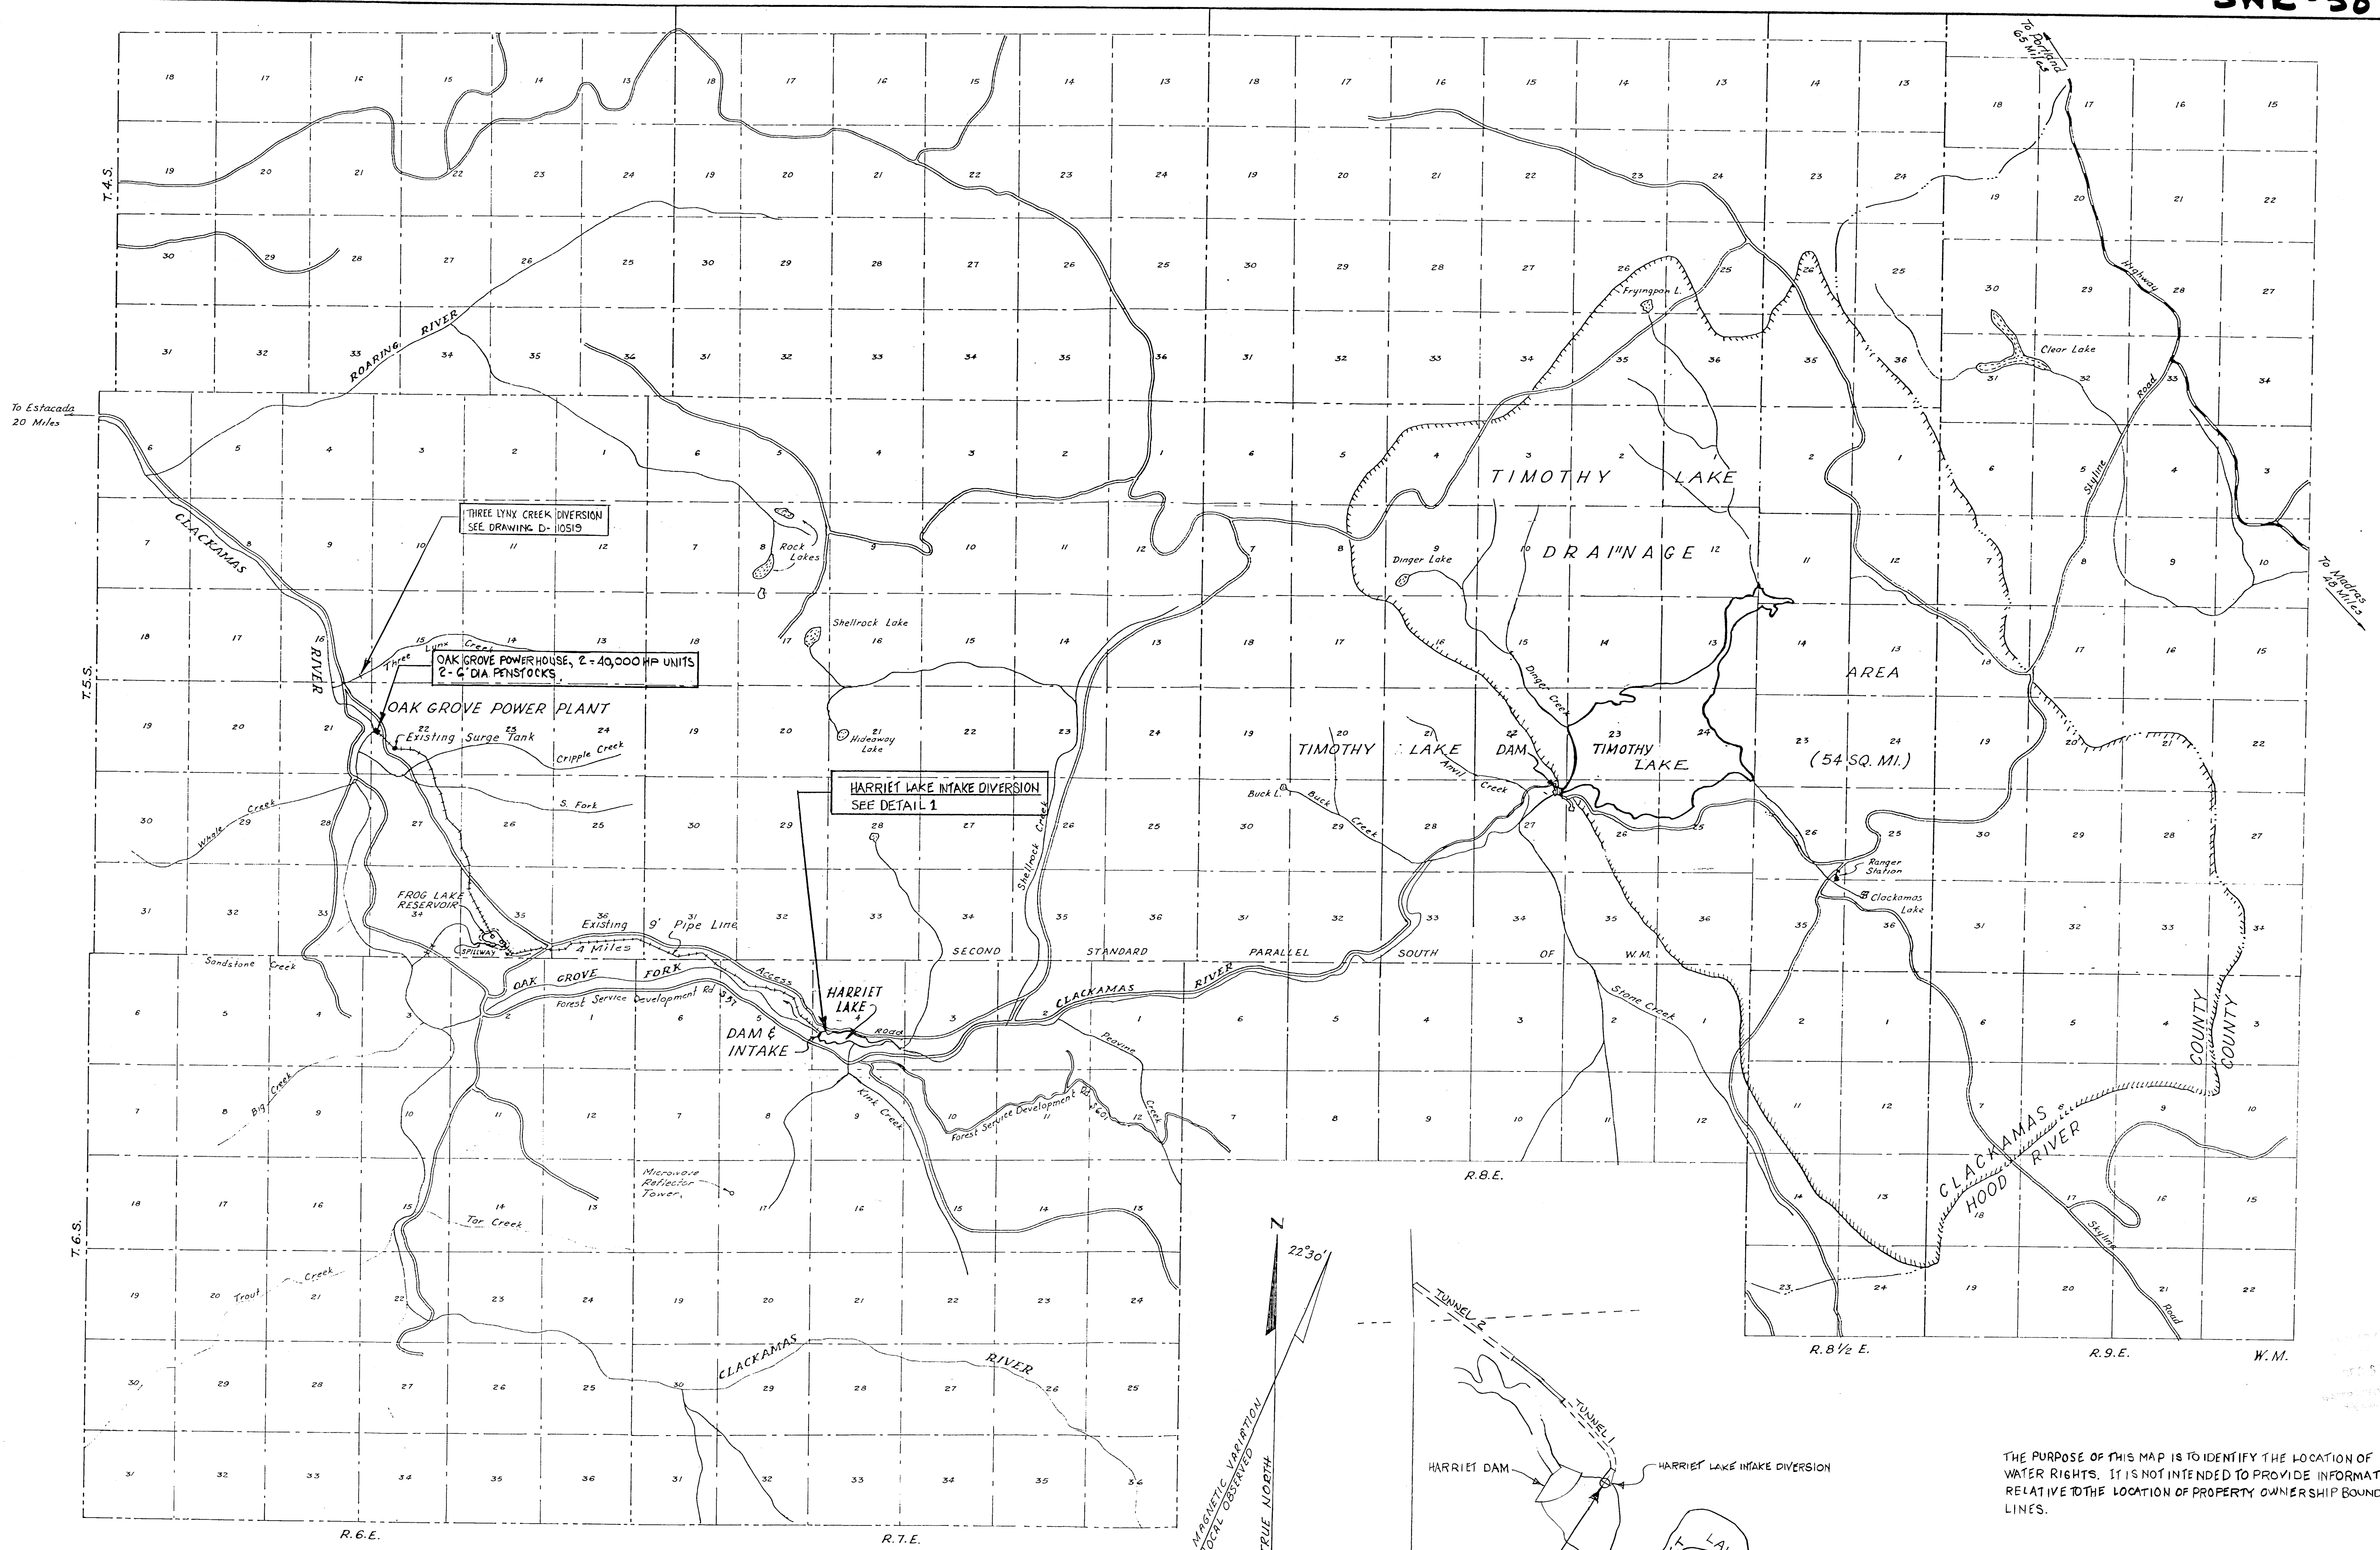

NOTE:
FOR LIST OF REFERENCE DRAWINGS
SEE DRAWING D-10519.

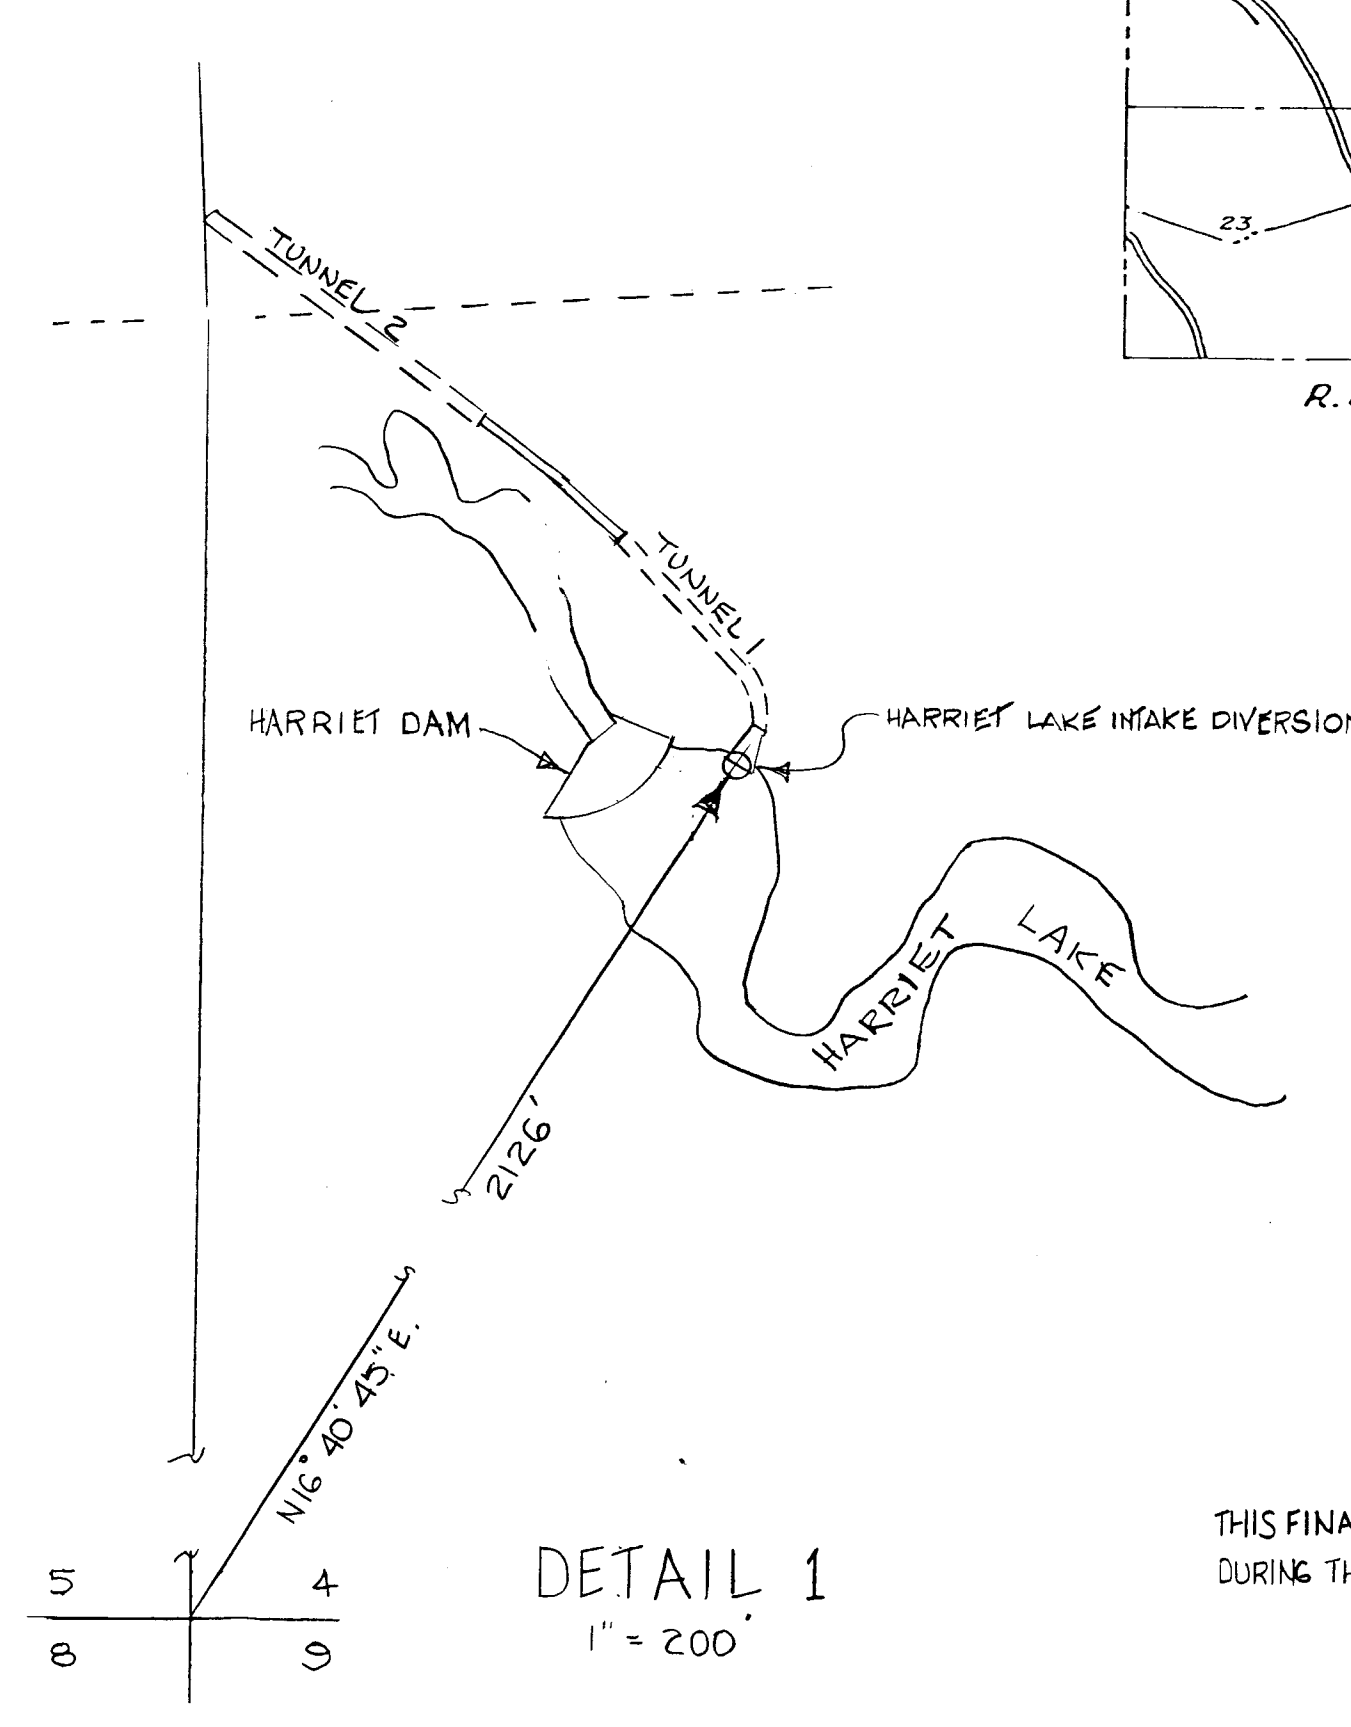

DETAIL 1
1" = 200'

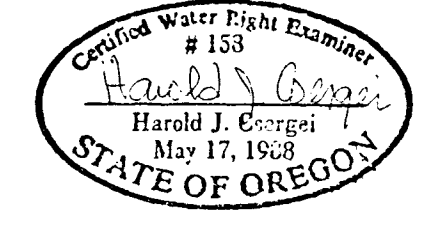

THIS FINAL PROOF SURVEY WAS PERFORMED
DURING THE PERIOD OCTOBER-DECEMBER, 1932.

THE PURPOSE OF THIS MAP IS TO IDENTIFY THE LOCATION OF
WATER RIGHTS. IT IS NOT INTENDED TO PROVIDE INFORMATION
RELATIVE TO THE LOCATION OF PROPERTY OWNERSHIP BOUNDARY
LINES.

REV. DATE	DESCRIPTION	BY	CHK	ENGR	SUPV	MGR
REVISIONS						
PORTLAND GENERAL ELECTRIC CO. PORTLAND, OREGON						
OAK GROVE PROJECT PRE 1909 VESTED WATER RIGHTS FINAL PROOF SURVEY						
APPROVALS				SCALE AS NOTED		
DESIGNER				DRAWN BY HJC		
DESIGN ENGR				CHECKED BY		
ENGR SUPV				DATE 12/28/32		
ENGR MANAGER				REV		
				C-20442		

SWR-387 2/2