

FARADAY POWERHOUSE
 3- 5000 HP UNITS
 1- 5500 HP UNIT
 1- 6500 HP UNIT
 4- 8 FOOT DIAMETER PENSTOCKS
 1- 9 FOOT DIAMETER PENSTOCK


FARADAY PROJECT
 1" = 400'

FISH LADDER ATTRACTION WATER DIVERSION
 54" DIAMETER PIPE
 FARADAY DAM DIVERSION -
 23" DIAMETER TUNNEL ENTRANCE

RECEIVED
 JUL 28 1992
 WATER RIGHTS DIVISION
 PORTLAND, OREGON

THE PURPOSE OF THIS MAP IS TO IDENTIFY THE LOCATION OF WATER RIGHTS. IT IS NOT INTENDED TO PROVIDE INFORMATION RELATIVE TO THE LOCATION OF PROPERTY OWNERSHIP BOUNDARY LINES.

- REFERENCE DRAWINGS
 FERC FARADAY PROJECT LICENSE DRAWINGS
 EXHIBIT L, SHT 16
 EXHIBIT L, SHT 17
 EXHIBIT L, SHT 27
 EXHIBIT L SHT 28

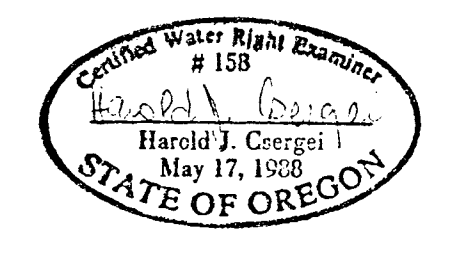

THIS FINAL PROOF SURVEY WAS PERFORMED DURING THE PERIOD OCTOBER-DECEMBER, 1992.

REV	DATE	DESCRIPTION	BY	CHK	ENGR	SUPV	MGR
REVISIONS							
PORTLAND GENERAL ELECTRIC CO. PORTLAND, OREGON							
FARADAY PROJECT PRE 1909 VESTED WATER RIGHTS FINAL PROOF SURVEY							
APPROVALS				SCALE 1" = 400'			
DESIGNER				DRAWN BY HJC			
DESIGN ENGR				CHECKED BY			
ENGR SUPV				DATE 12/23/92			
ENGR MANAGER				REV C-20441			

SWR-388