

T30S R5W WM
SECTION 34

NW 1/4
NE 1/4

DLC 59

SE COR.
DLC 59

BEARINGS AND
SURVEY TIE BASED
ON CAÑON
MANOR
ESTATES



SW 1/4
NE 1/4

0.3 Ac.

SE 1/4
NE 1/4

LOT 6

SE 1/4
NW 1/4


DITCH

LOT 5
NE 1/4
SW 1/4

DLC
58
NW 1/4
SE 1/4

SECTION
SUBDIVISION LINES
PROJECTED IN
DLC

2123.5 (CALC S 34° 43' 30" E 2123.5 PER CITY OF CANYONVILLE PERMIT)

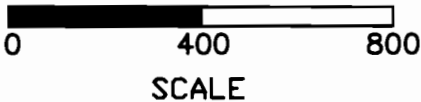

DIVERSION PT

CANYON CREEK

SURVEY OF CLAIM FOR VESTED WATER RIGHT

IN NAME OF *ADA O. PLACE*

DATE JANUARY 1990

BY: WILLIAM J. RUPPERT
P.O. BOX 1564
MYRTLE CREEK, OR 97457