


No.	Description	POINTS OF DIVERSION Corner Tie	No. of Cattle	1/4 1/4 Section
1	Spring	450 ft. North & 640 ft. East of the west 1/4 corner of Section 36		SW 1/4 NW 1/4 Section 36
2	"	220 ft. North & 1,100 ft. East of the west 1/4 corner of Section 36	100	" "
3	"	160 ft. North & 2,410 ft. East of the west 1/4 corner of Section 36	100	SE 1/4 NW 1/4 Section 36
P.O.D. 1	Handschrabble Creek	100 ft. South & 1,360 ft. West of the east 1/4 corner of Section 36	100	NW 1/4 SE 1/4 Section 36
P.O.D. 2	"	720 ft. North & 1,660 ft. West of the SE corner of Section 36	100	SW 1/4 SE 1/4 Section 36
P.O.D. 3	"	180 ft. South & 1,450 ft. West of the NE corner of Section 36	100	NW 1/4 NE 1/4 Section 36
P.O.D. 4	"	1,730 ft. South & 1,380 ft. West of the NE corner of Section 25	100	SW 1/4 NE 1/4 Section 25

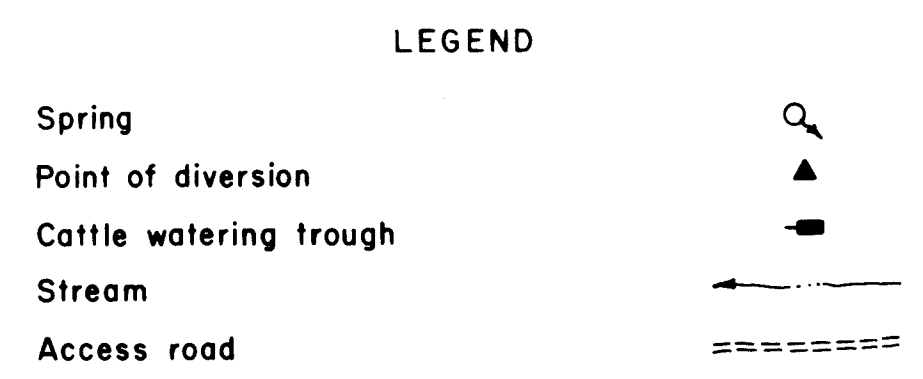

**WATER USE REGISTRATION MAP FOR ADJUDICATION IN THE JAMES MCGRANARY DONATION LAND CLAIM NO. 38 AND SECTIONS 25 & 36, T 21 S, R 6 W, W. M. AND IN THE JAMES MCGRANARY DONATION LAND CLAIM NO. 43 & THE SOLOMON ENSLEY DONATION LAND CLAIM NO. 44 AND SECTION 1, T 22 S, R 6 W, W. M., DOUGLAS COUNTY, OREGON**

Application No. \_\_\_\_\_  
Permit No. \_\_\_\_\_

For: Trust A  
P. O. Box 578  
Drain, Oregon 97435

By: Shaner Engineering, Inc.  
P. O. Box 1430  
Roseburg, Oregon 97470



December 29, 1992