


SECTION 1, T.10 S., R.10 W.W.M.
LINCOLN COUNTY

1" = 400
SEE MAP 9 10

FOR ASSESSORS OFFICE USE ONLY


10 10 1

CRAIG & KERRI TYLER

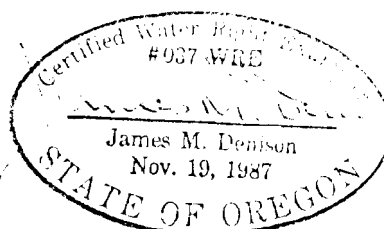

CANCELLED NOS

- 100
- 200
- 300
- 400
- 500
- 600
- 1500
- 1601
- 1602
- 1700
- 1200
- 1100-II
- 1400-II
- 1600
- 1801
- 1800
- 700
- 1900-31

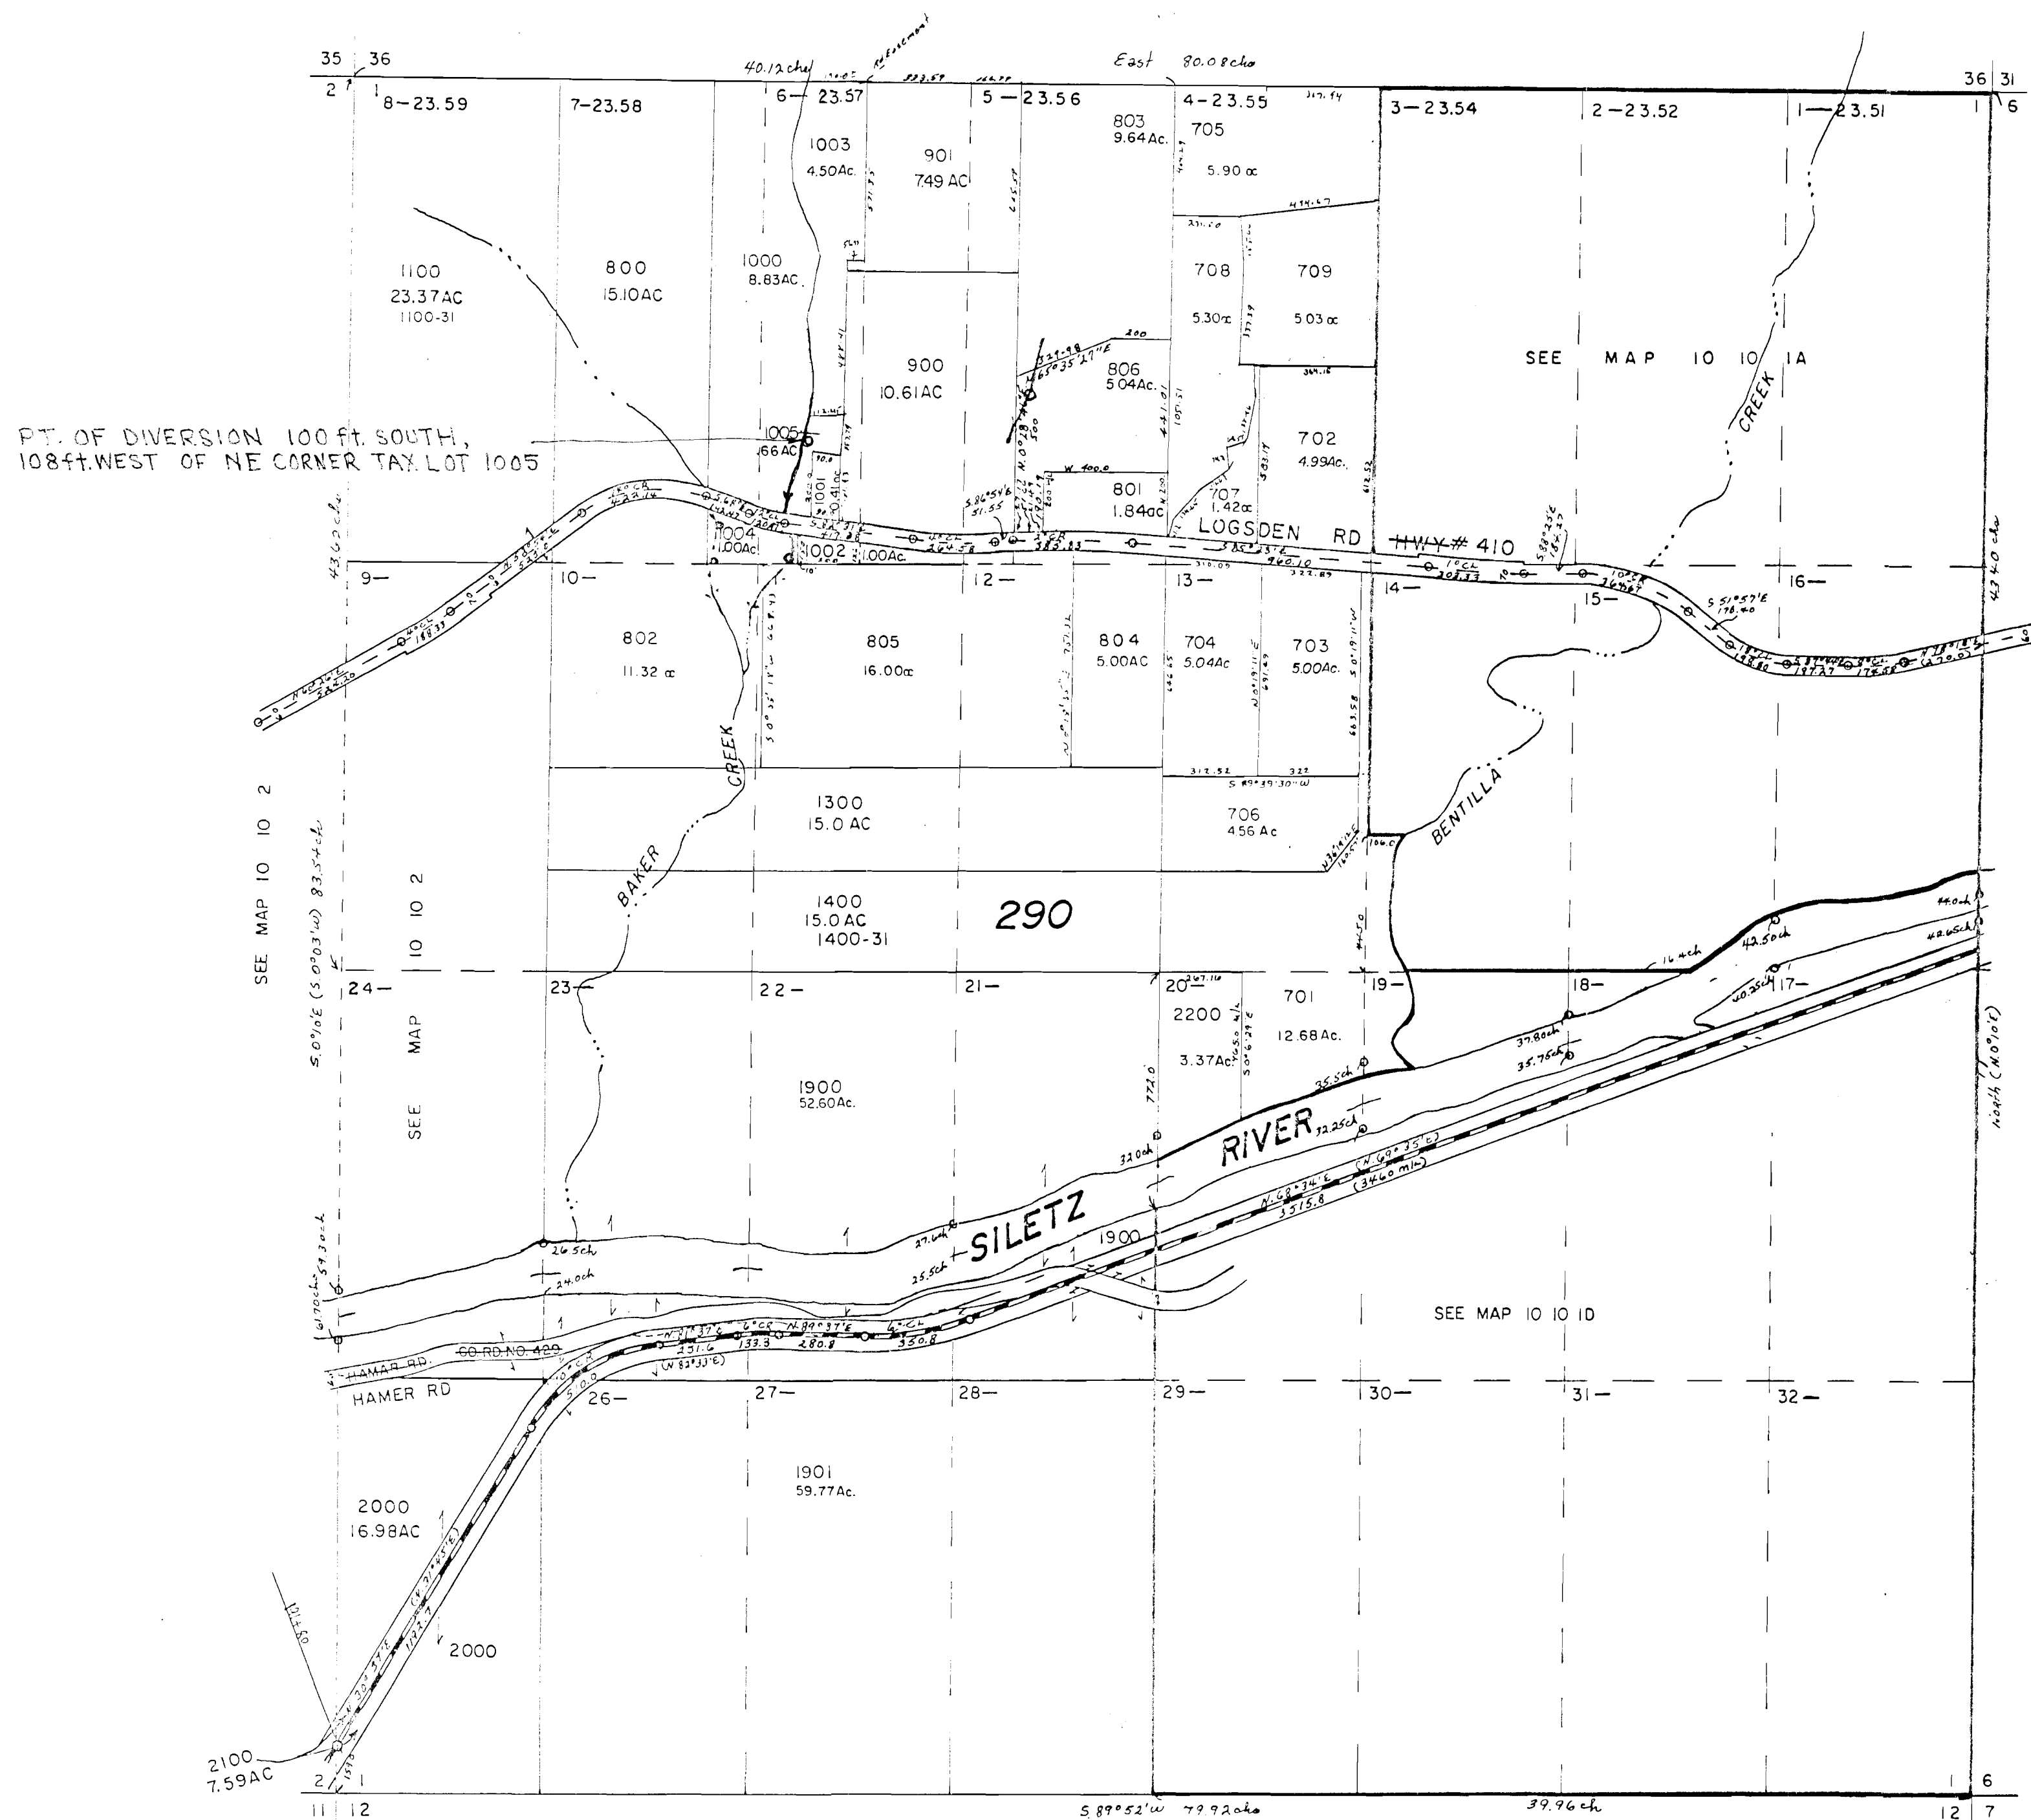

10 10 1