


1" = 400
SEE MAP 9 10

10 10 1

Certified Water Right
#937 WRD
James M. Denison
Nov. 19, 1987
STATE OF OREGON

100
200
300
400
500
600
1500
1601
1602
1700
1200
1100-II
1400-II
1600
1801
1800
700
1900-31

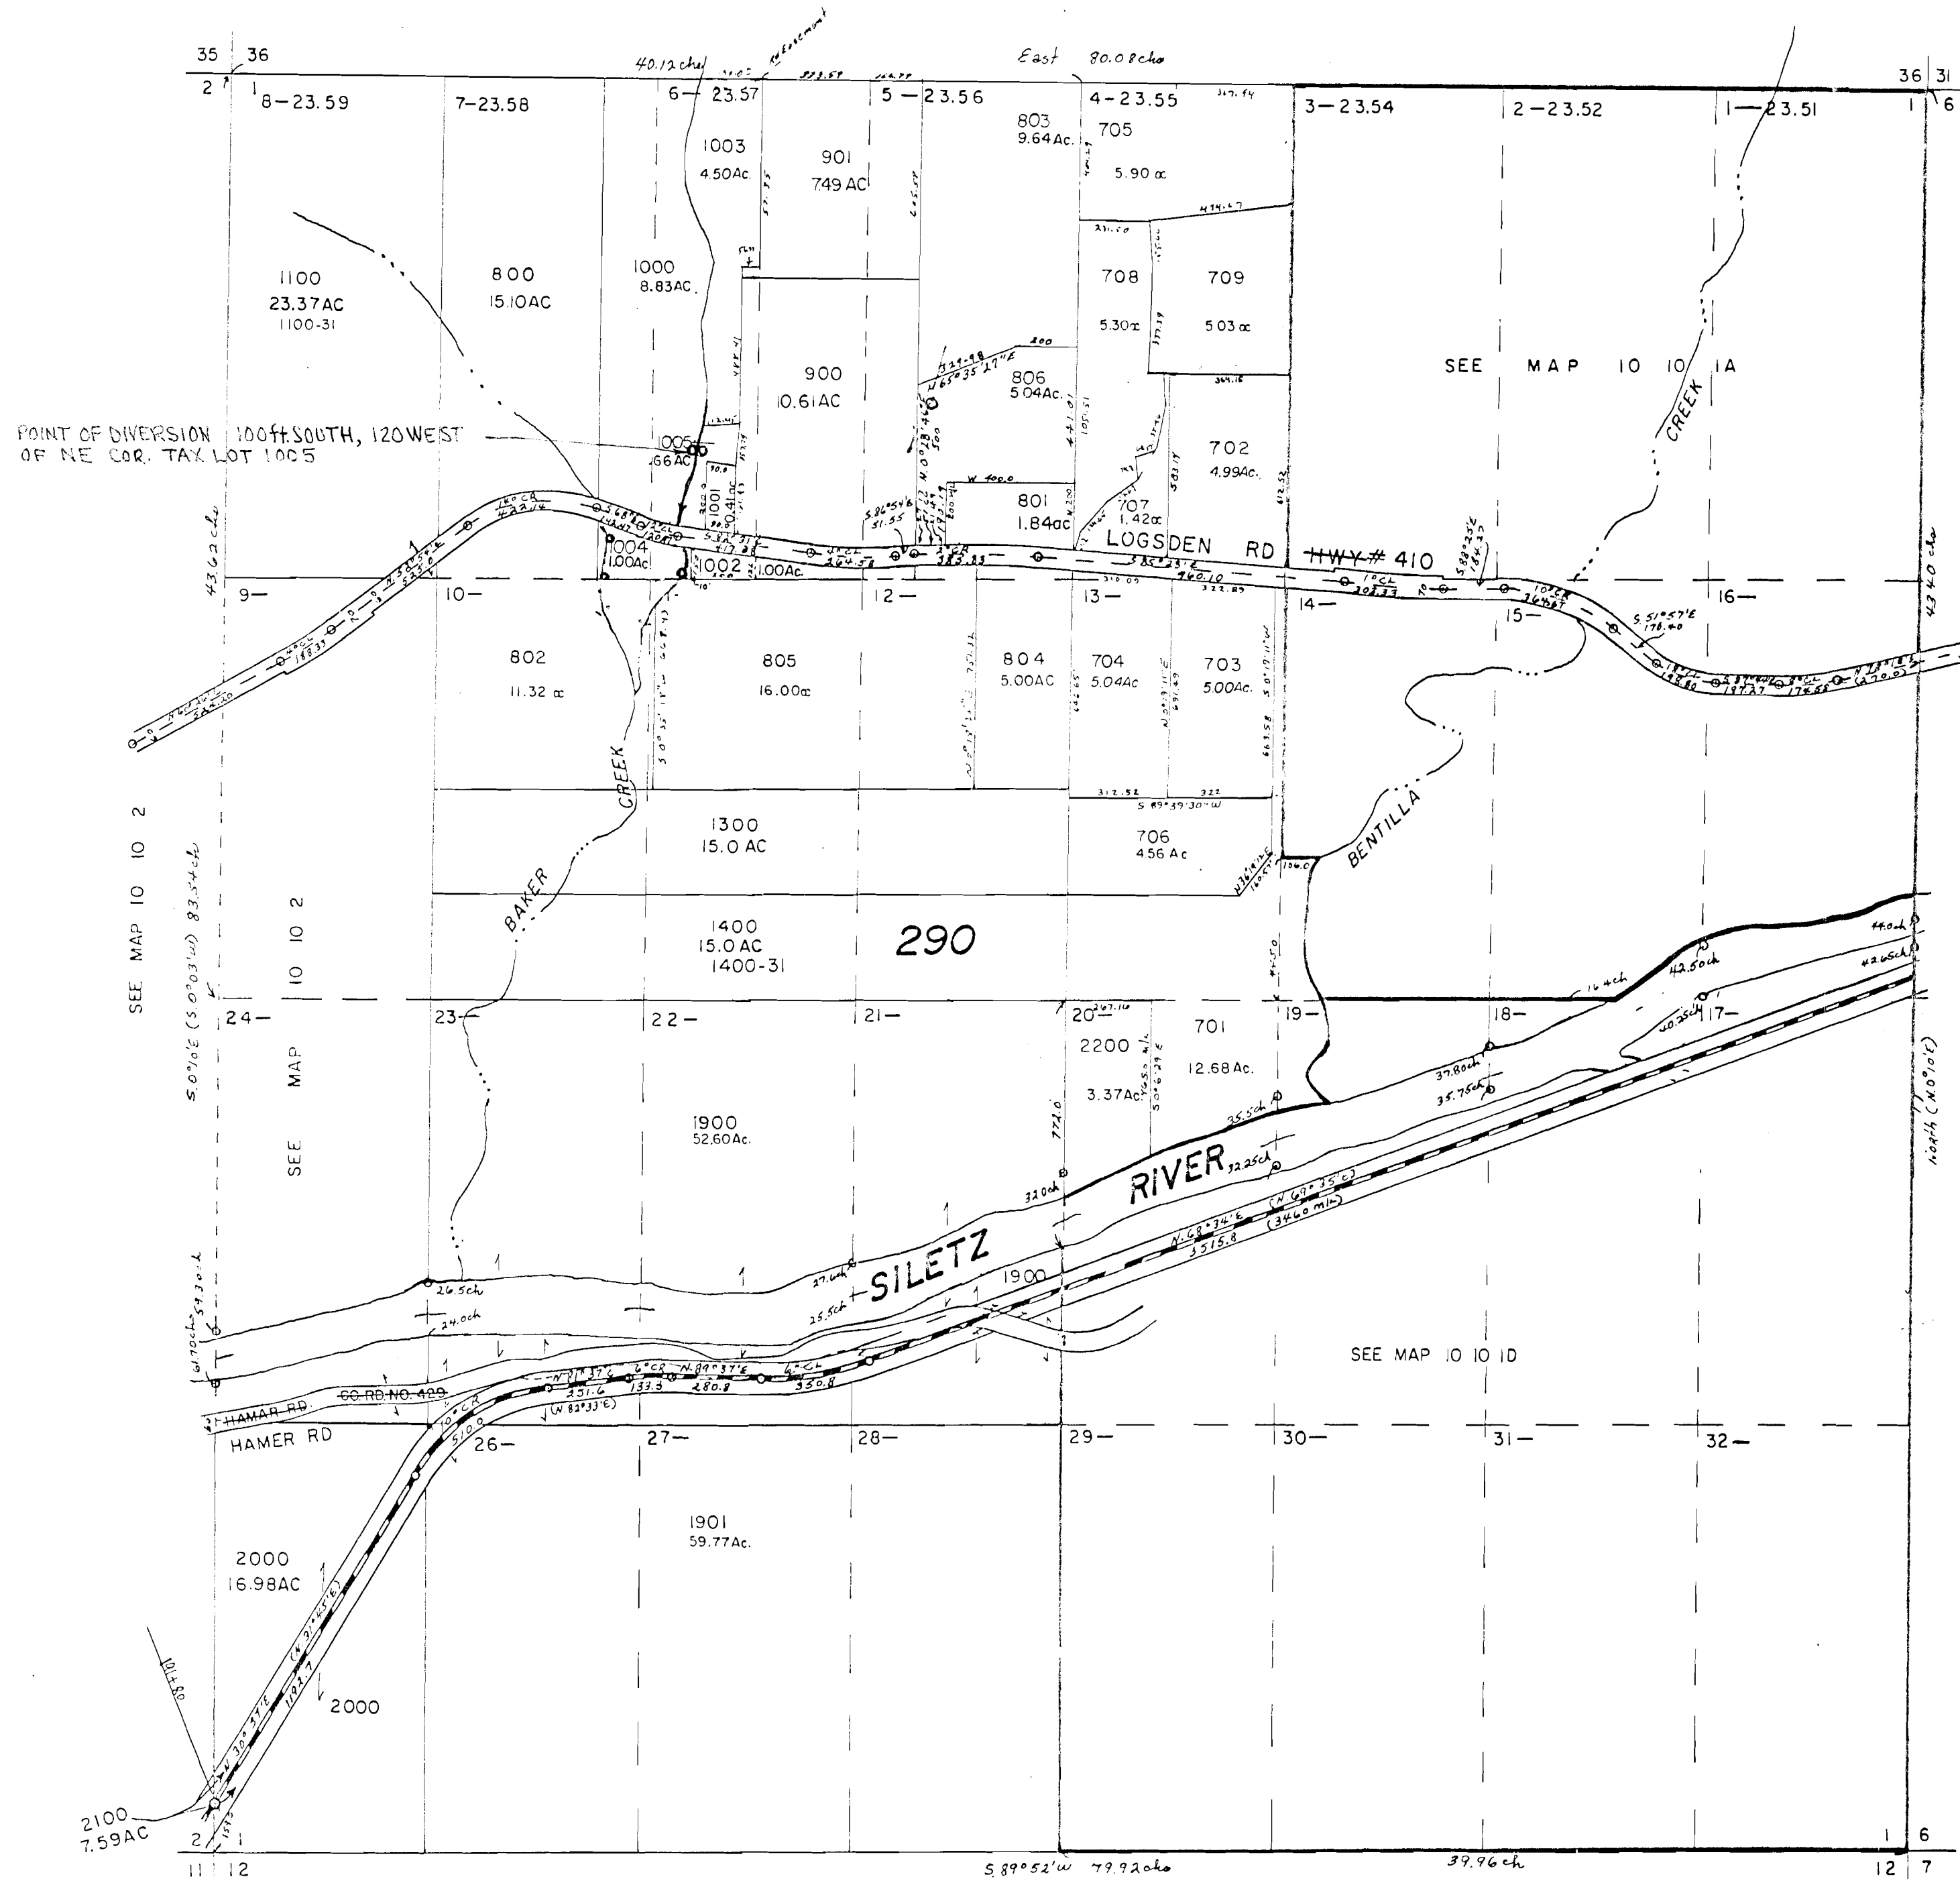

10 10 1