
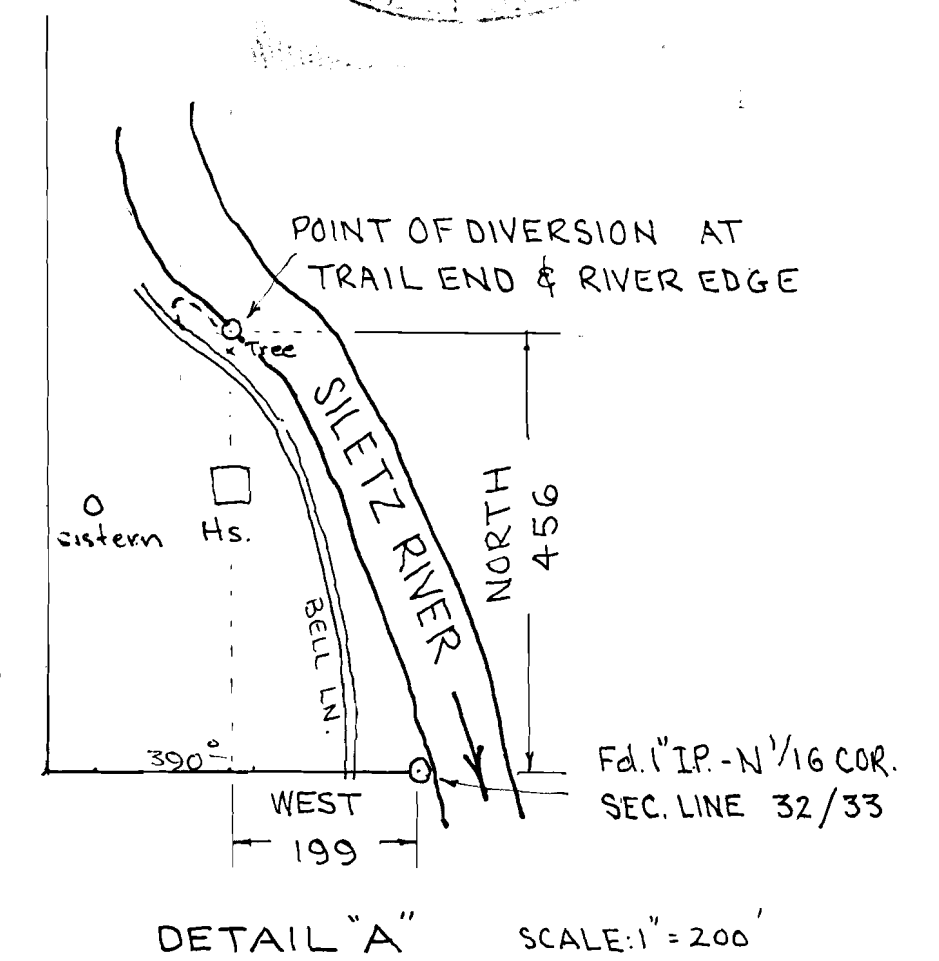


$$I'' = 400'$$

9 9 32

DEAD
300-II
700-II

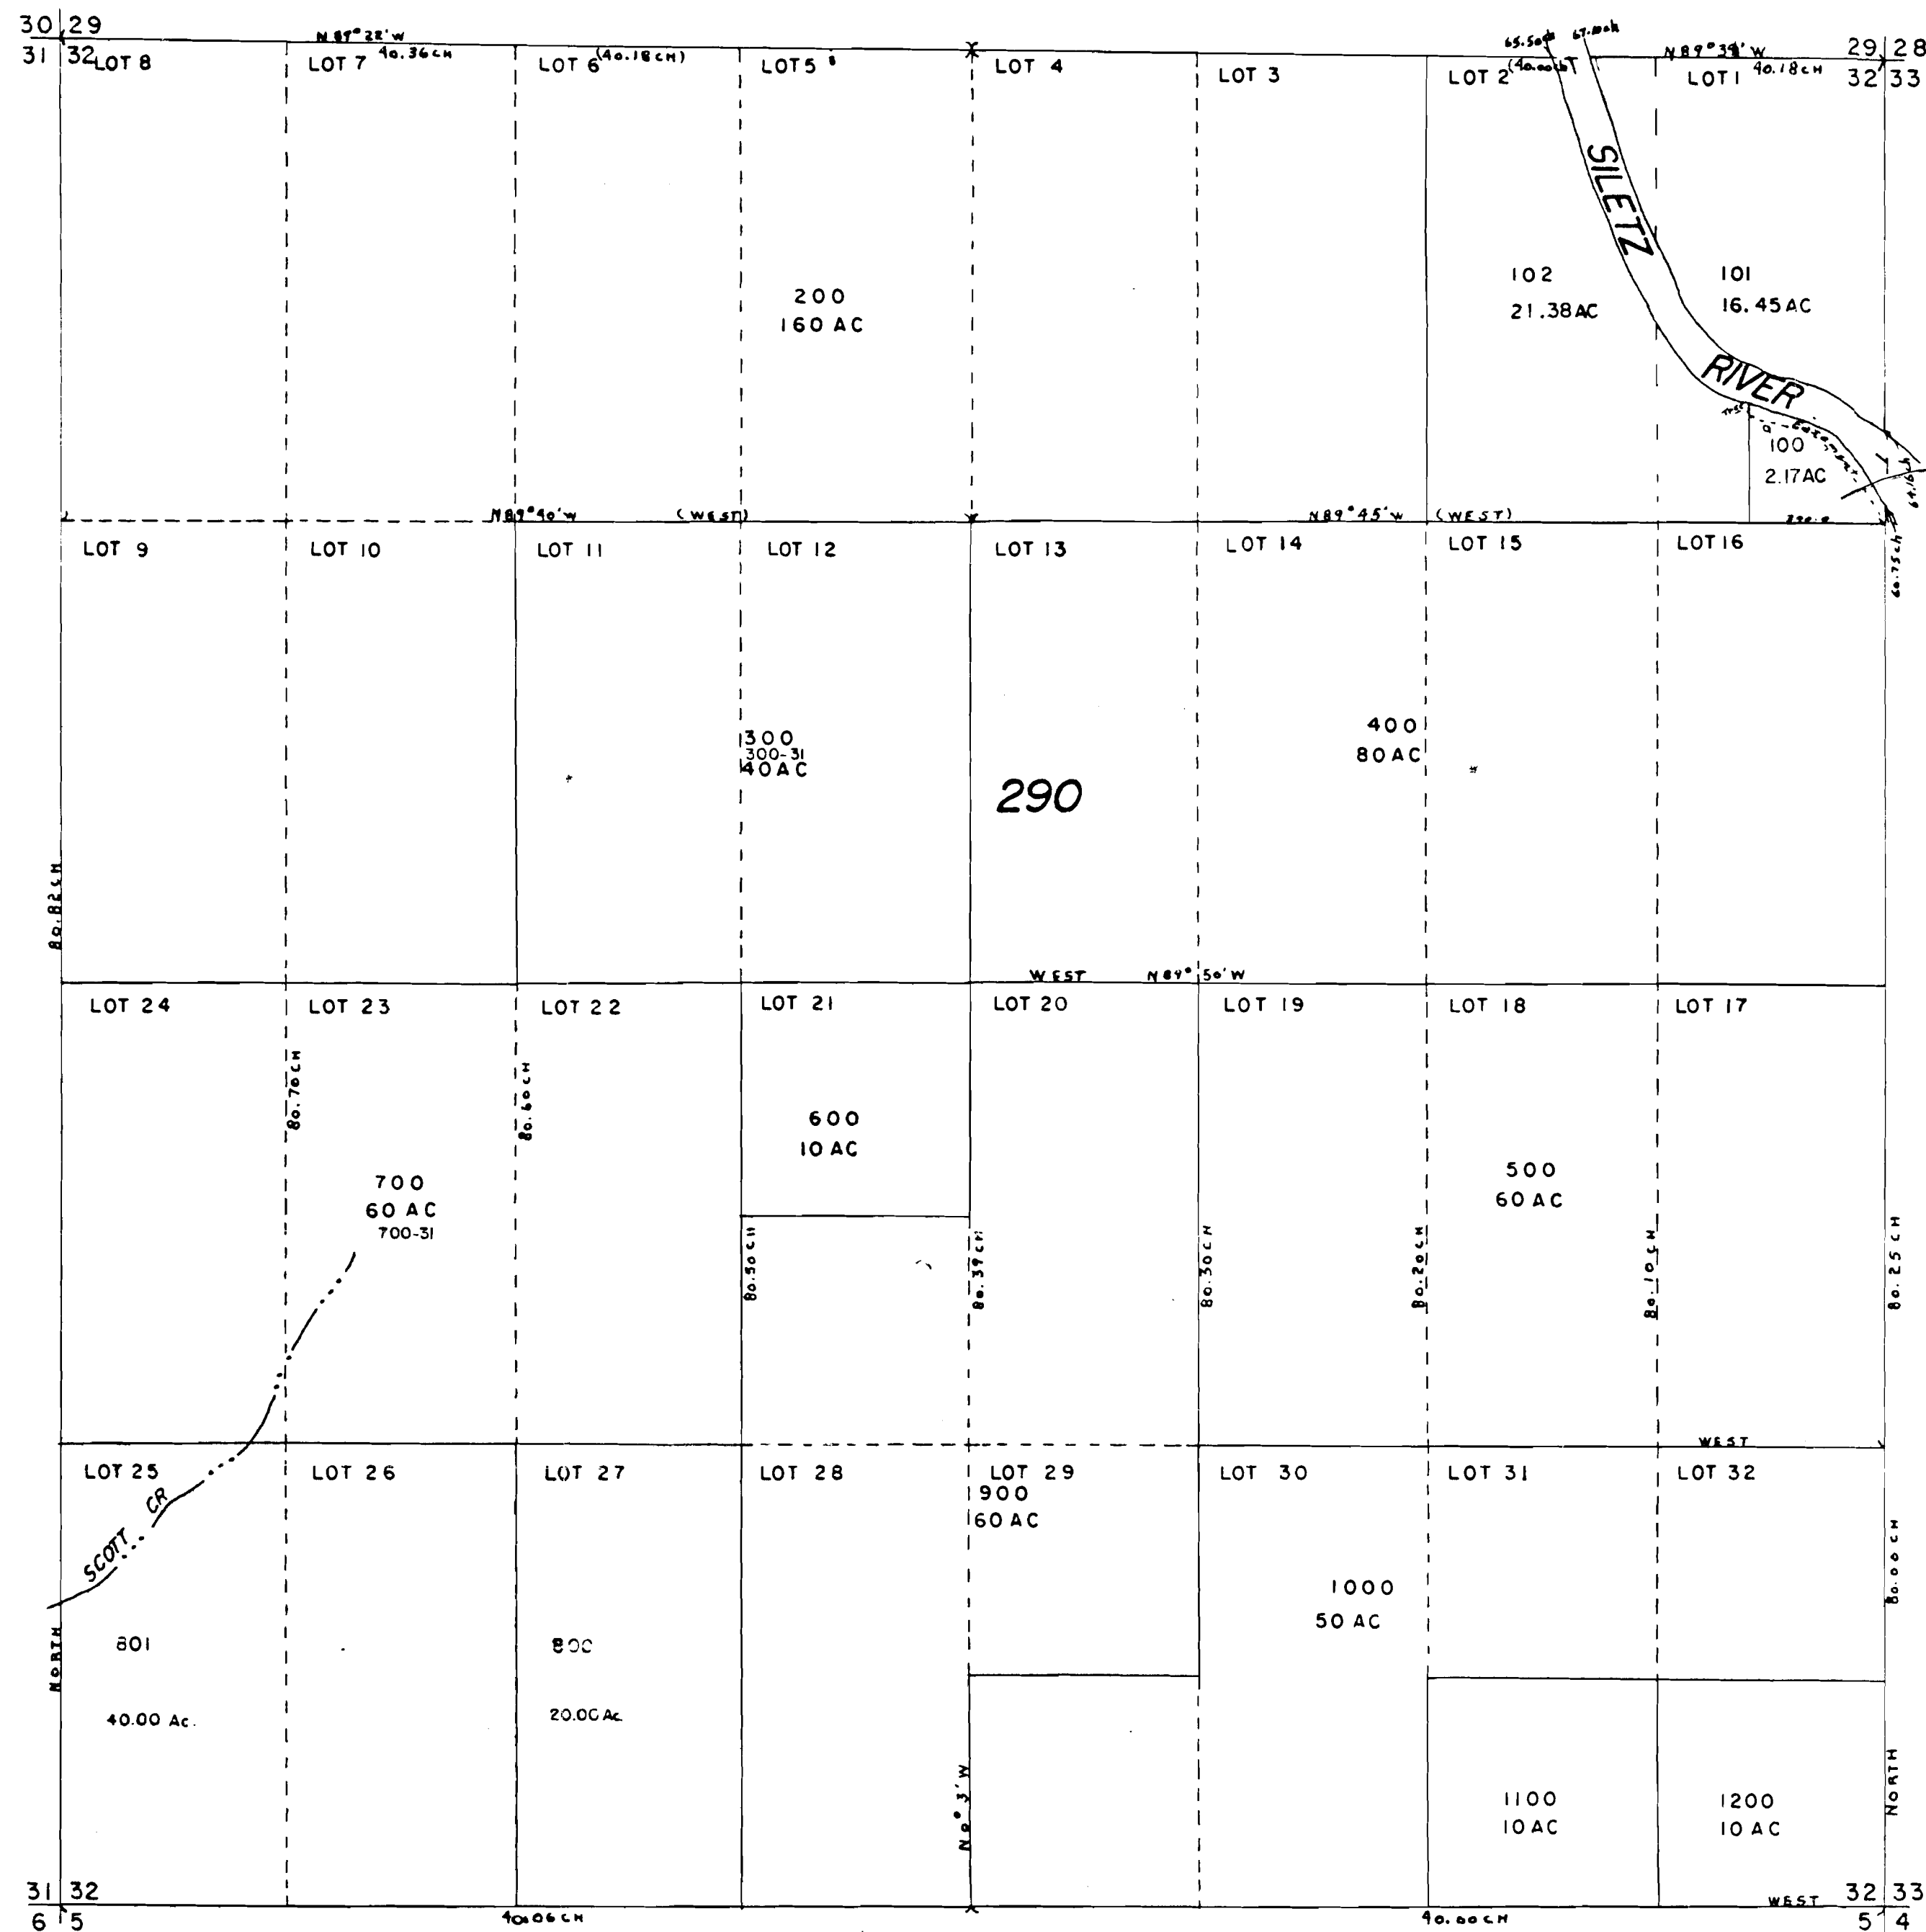

See Map 10 9