


No.	Description	POINTS OF DIVERSION Corner Tie	No. of Cattle	1/4 1/4 Section
1	Jack Creek	1,720 ft. South & 1,400 ft. East of the NW corner of Section 2	100	SE 1/4 NW 1/4 Section 2
2	"	380 ft. North & 340 ft. East of the SW corner of Section 2	100	SW 1/4 SW 1/4 Section 2

LEGEND

- Point of diversion & cattle watering trough
- Stream
- Access road

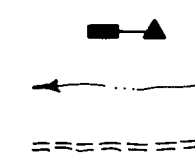


WATER USE REGISTRATION MAP FOR ADJUDICATION IN
THE JAMES FARMER DONATION LAND CLAIM NO. 40
AND IN SECTIONS 2 & 3, T 22 S, R 6 W, W. M.,
DOUGLAS COUNTY, OREGON

Application No. _____

Permit No. _____

For: Trust A
P. O. Box 578
Drain, Oregon 97435

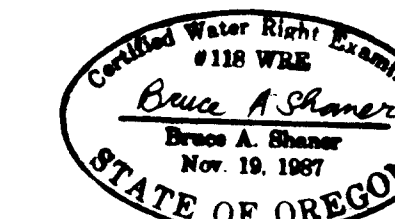

By: Shaner Engineering, Inc.
P. O. Box 1430
Roseburg, Oregon 97470