

Scale: 1" = 400 ft.

No.	Description	POINT OF DIVERSION Corner Tie	No. of Cattle*	1/4 1/4 Section
1	Spring	760 ft. South & 880 ft. West of the NE corner Section 1, T 23 S, R 8 W, W. M.	250	NE 1/4 NE 1/4 Section 1

*Plus domestic, 2 residences.

LEGEND


- Spring
- Cattle watering trough
- Stream
- Access road

WATER USE REGISTRATION MAP FOR ADJUDICATION IN THE IRA WELLS D.L.C. NO. 56 AND SECTION 36, T 22 S, R 8 W, W. M., & IN THE IRA WELLS D.L.C. NO. 37 AND SECTION 1, T 23 S, R 8 W, W. M., DOUGLAS COUNTY, OREGON

Application No. _____
Permit No. _____

For: Eagles View Management Co.
P. O. Box 10638
Eugene, Oregon 97440

By: Shaner Engineering, Inc
P. O. Box 1430
Roseburg, Oregon 97470

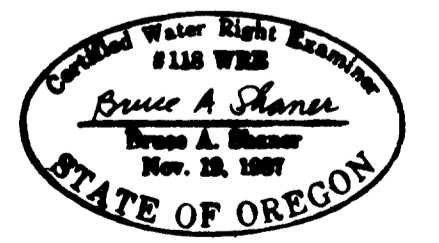

December 29, 1992