

Scale: 1" = 400 ft.

No.	Description	POINTS OF DIVERSION Corner Tie	No. of Stock	1/4 1/4 Section
1	Spring	730 ft. South & 2,490 ft. West of the east 1/4 corner of Section 23	100	NW 1/4 SE 1/4 Section 23
2	"	140 ft. North & 2,440 ft. East of the west 1/4 corner of Section 23	100	SE 1/4 NW 1/4 Section 23
3	"	910 ft. South & 1,320 ft. West of the NE corner of Section 23	100	NE 1/4 NE 1/4 Section 23
4	"	410 ft. North & 1,570 ft. East of the west 1/4 corner of Section 23	100	SE 1/4 NW 1/4 Section 23
5	"	1,040 ft. South & 340 ft. East of the NW corner of Section 23	100	NW 1/4 NW 1/4 Section 23
6	"	640 ft. South & 1,100 ft. East of the NW corner of Section 23	100	" "
7	"	110 ft. South & 880 ft. East of the NW corner of Section 23	100	" "
8	"	1,170 ft. North & 2,460 ft. East of the west 1/4 corner of Section 23	100	SE 1/4 NW 1/4 Section 23
9	"	180 ft. South & 270 ft. East of the north 1/4 corner of Section 23	100	NW 1/4 NE 1/4 Section 23
10	"	420 ft. South & 850 ft. East of the north 1/4 corner of Section 23	100	" "
11	"	90 ft. North & 1,420 ft. West of the SE corner of Section 14	100	SW 1/4 SE 1/4 Section 14
12	"	940 ft. North & 970 ft. West of the SE corner of Section 14	100	SE 1/4 SE 1/4 Section 14
13	"	380 ft. North & 120 ft. West of the south 1/4 corner of Section 14	0	SE 1/4 SW 1/4 Section 14
14	"	590 ft. North & 120 ft. West of the south 1/4 corner of Section 14	0	" "

No.	Description	POINTS OF DIVERSION Corner Tie	No. of Stock	1/4 1/4 Section
P.O.D. 1	Elk Creek	890 ft. North & 1,530 ft. East of the west 1/4 corner of Section 23	100	SE 1/4 NW 1/4 Section 23
" 2	"	590 ft. North & 2,410 ft. East of the west 1/4 corner of Section 23	100	" "
" 3	"	1,210 ft. North & 2,070 ft. West of the east 1/4 corner of Section 23	100	SW 1/4 NE 1/4 Section 23
" 4	"	630 ft. South & 1,230 ft. West of the NE corner of Section 23	100	NE 1/4 NE 1/4 Section 23
" 5	"	470 ft. South & 440 ft. West of the NE corner of Section 23	100	" "
" 6	"	930 ft. North & 170 ft. West of the SE corner of Section 14	100	SE 1/4 SE 1/4 Section 14
15	Spring	130 ft. South & 980 ft. West of the north 1/4 corner of Section 23	100	NE 1/4 NW 1/4 Section 23
16	"	680 ft. North & 1,070 ft. West of the south 1/4 corner of Section 14	100	SE 1/4 SW 1/4 Section 14

LEGEND


- Spring
- Point of diversion
- Stock watering trough
- Stream
- Access road

WATER USE REGISTRATION MAP FOR ADJUDICATION
in Sections 14 & 23, T 22 S, R 5 W, W. M.,
Douglas County, Oregon

Application No. _____
Permit No. _____

For: Martin A. Thompson
2198 Boswell Road
Yoncalla, Oregon 97499

By: Shaner Engineering, Inc.
P. O. Box 1430
Roseburg, Oregon 97470

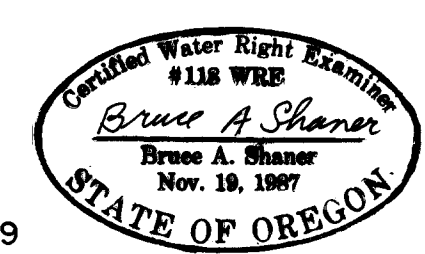

December 29, 1992

SWR-425