


T. 27S., R. 7 W., W.M.

SCALE: 1" = 1320'

REGISTRATION STATEMENT MAP

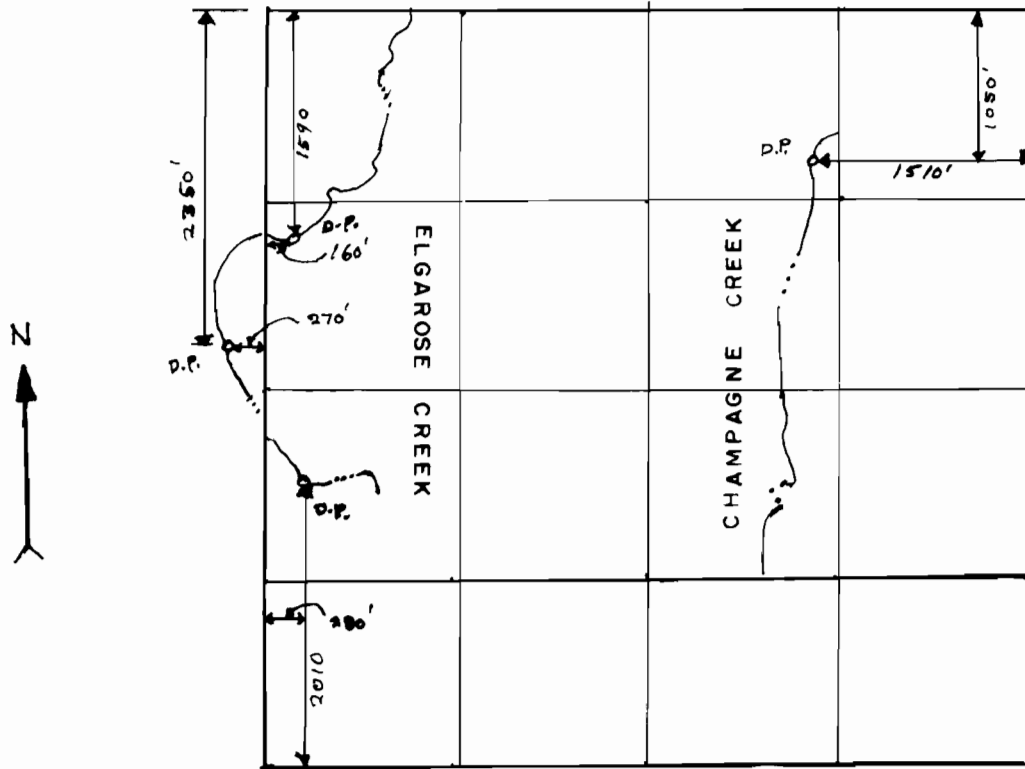

SECTION 12

THE PURPOSE OF THIS MAP IS TO IDENTIFY THE LOCATION OF THE WATER RIGHT. IT IS NOT INTENDED TO PROVIDE INFORMATION RELATIVE TO THE LOCATION OF PROPERTY OWNERSHIP BOUNDARY LINES.

UNDER

IN NAME OF

JOHN B. RICHARDS

Surveyed DEC. 29, 1992, by DUANE KIRBY

