


T.28S. R.12W. W.M.

RECEIVED

DEC 31 1992

WATER RESOURCES DEPT.
SALEM, OREGON

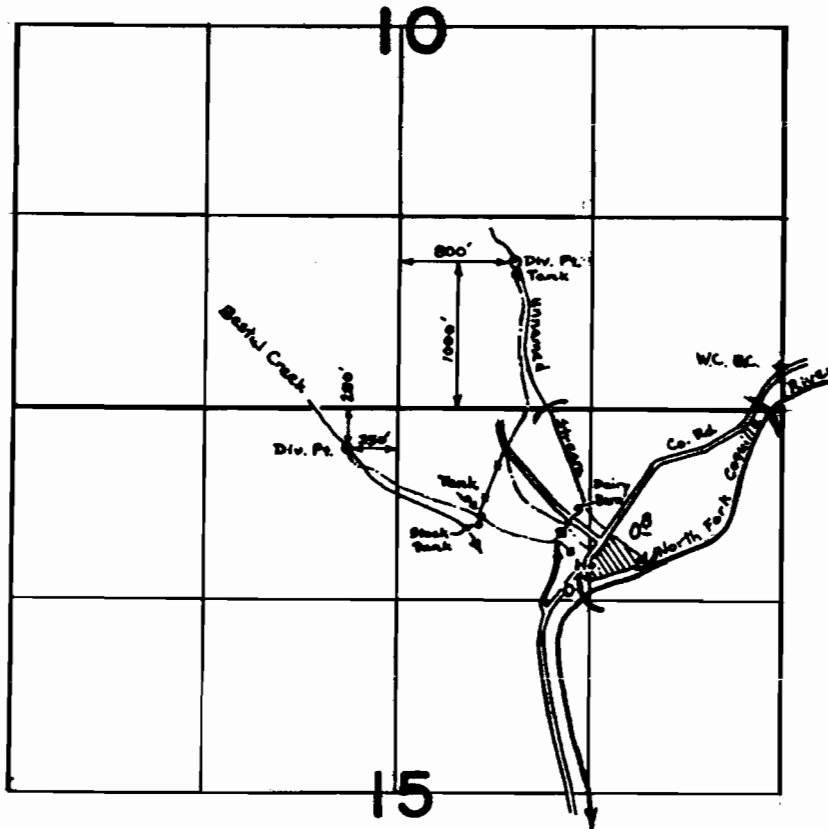

FINAL PROOF SURVEY

UNDER

47568 35615

54462 40854

Application No. 56191 Permit No. 42297

IN NAME OF

CECIL A. and/or BLANCH WELZHEIMER

Surveyed July.22.. 1980, by S.Donaldson.....