
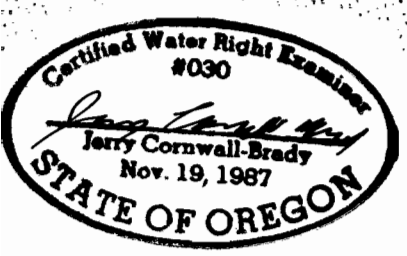
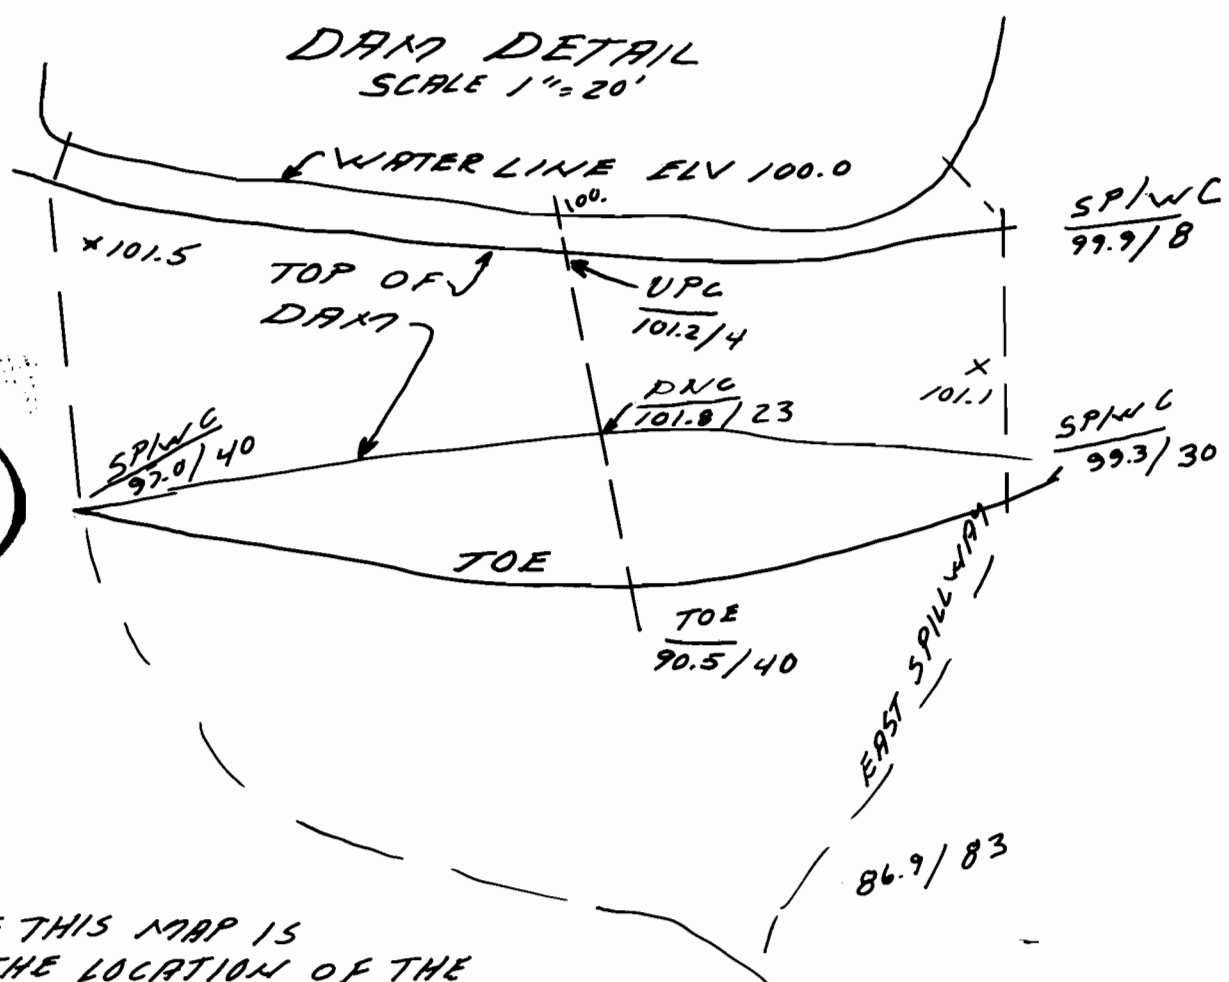


SURFACE WATER REGISTRATION SURVEY
 FOR GLENN O. TARBELL & LOREN G. TARBELL
 IN THE PHILLIP LAFFER D.L.C.
 IN THE EAST 1/2 OF SEC 24 T4N R2W WM
 COLUMBIA COUNTY ORE
 DEC. 10 1993

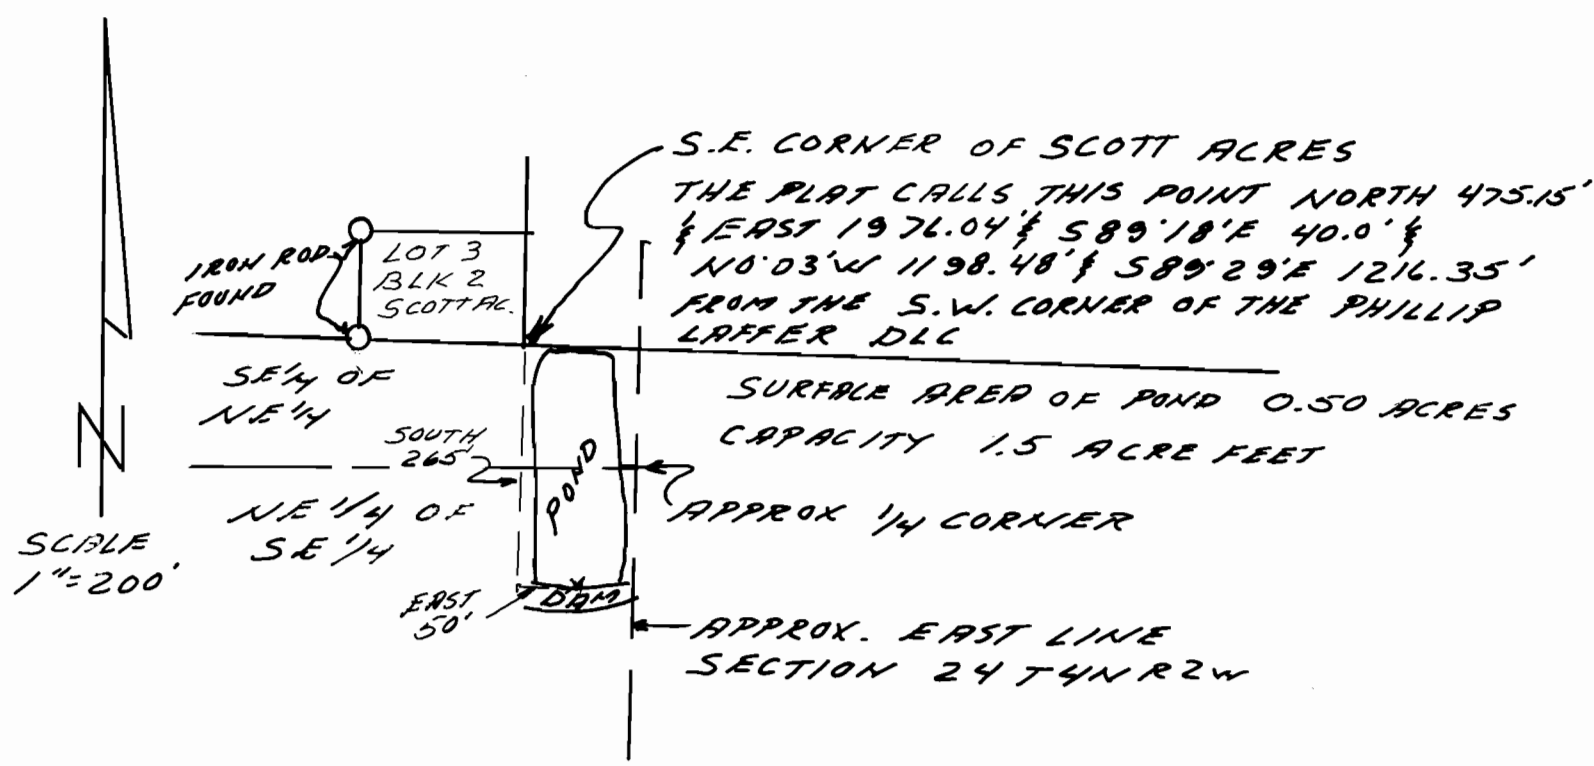

RENEWAL DATE
 12-31-93

THE PURPOSE OF THIS MAP IS TO IDENTIFY THE LOCATION OF THE WATER RIGHT. IT IS NOT INTENDED TO PROVIDE INFORMATION RELATIVE TO THE LOCATION OF PROPERTY OWNERSHIP LINES.