
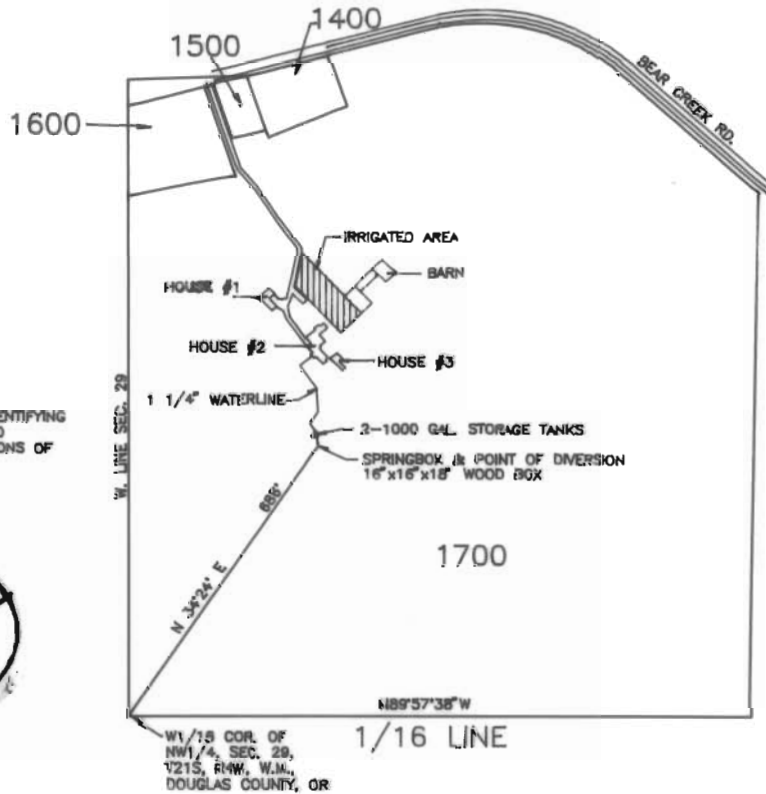


PROPERTY OWNER:
 BILLY RAY BROCH
 P.O. BOX 74
 CURTIN, OR 97428

THIS MAP IS FOR THE PURPOSE OF IDENTIFYING
 THE WATER RIGHT ONLY AND IS NOT TO
 PROVIDE LEGAL DIMENSIONS OR LOCATIONS OF
 PROPERTY OWNERSHIP LINES.

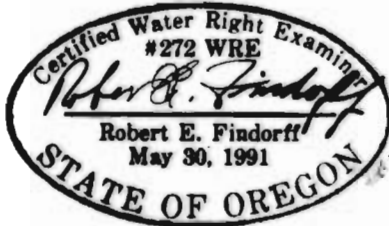

RECEIVED
 JAN - 3 1994
 WATER RESOURCES DEPT.
 SALEM, OREGON

WATER RIGHTS SURVEY FOR
 BILLY RAY BROCH
 T.L. 21-04-29-1700
 NW1/4, NW1/4
 SEC. 29, T21S, R4W, W.M.,
 DOUGLAS COUNTY, OR



SCALE: 1" = 400'



Geomax
 OF OREGON, INC.

ENGINEERING, LAND SURVEYING, BUILDING DESIGN
 808 N. NINTH STREET COTTAGE GROVE, OREGON 97424
 TELEPHONE- (503) 942-0126 FAX- (503) 942-7935

JOB NO.: 92141	DRAWN: T.F.J.	CHECKED: R.E.F.
DATE: 12/27/93	SHT. 1	OF 1