

**SURFACE WATER REGISTRATION STATEMENT MAP  
PRE-1909 WATER RIGHT CLAIM  
IN THE NAME OF INEZ ADAMS LIVING TRUST**

**SECTIONS 14 AND 23, TOWNSHIP 22 SOUTH, RANGE 6 WEST, W.M.**


**RECEIVED**

MAY 26 1993

WATER RESOURCES DEPT.  
SALEM, OREGON



1 INCH = 1320 FEET

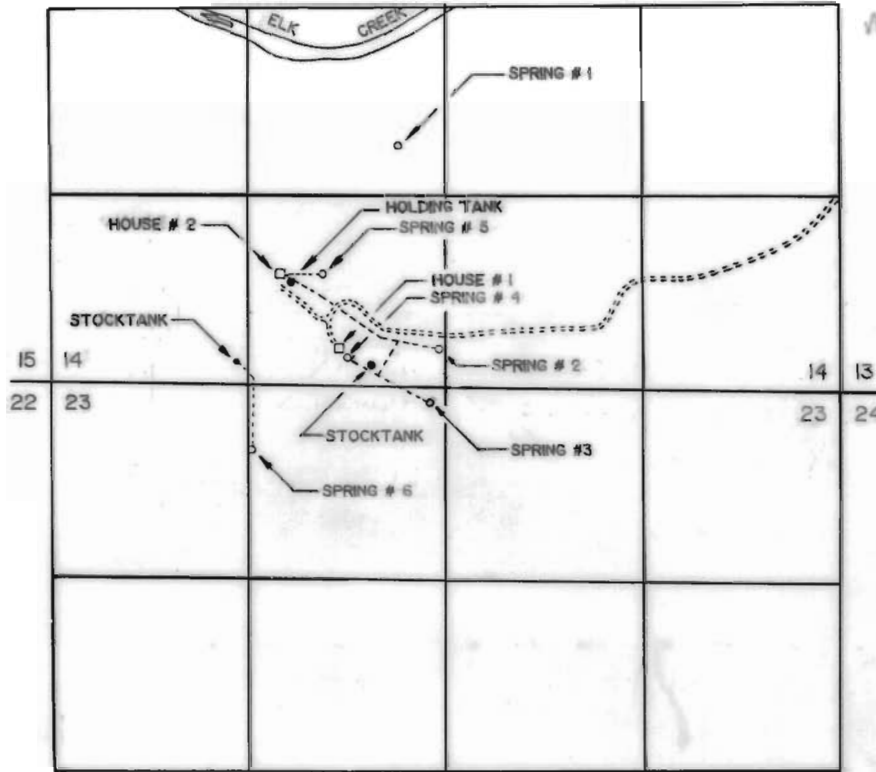

SPRING #	FEET N/S	FEET E/W	FROM	1/4 1/4	SECTION
1	1650 N	2380 E	SW COR S14	NE1/4 SW1/4	14
2	260 N	2590 E	SW COR S14	SE1/4 SW1/4	14
3	100 S	2630 E	SW COR S14	NE1/4 NW1/4	23
4	190 N	2020 E	SW COR S14	SE1/4 SW1/4	14
5	770 N	1860 E	SW COR S14	SE1/4 SW1/4	14
6	440 S	1360 E	SW COR S14	NE1/4 NW1/4	23

ALL SPRINGS BEING WITHIN TOWNSHIP 22 SOUTH, RANGE 6 WEST, W.M., DOUGLAS COUNTY.

THE PURPOSE OF THIS MAP IS TO IDENTIFY THE LOCATION OF THE WATER RIGHT. IT IS NOT INTENDED TO PROVIDE INFORMATION RELATIVE TO THE LOCATION OF PROPERTY OWNERSHIP BOUNDARY LINES.