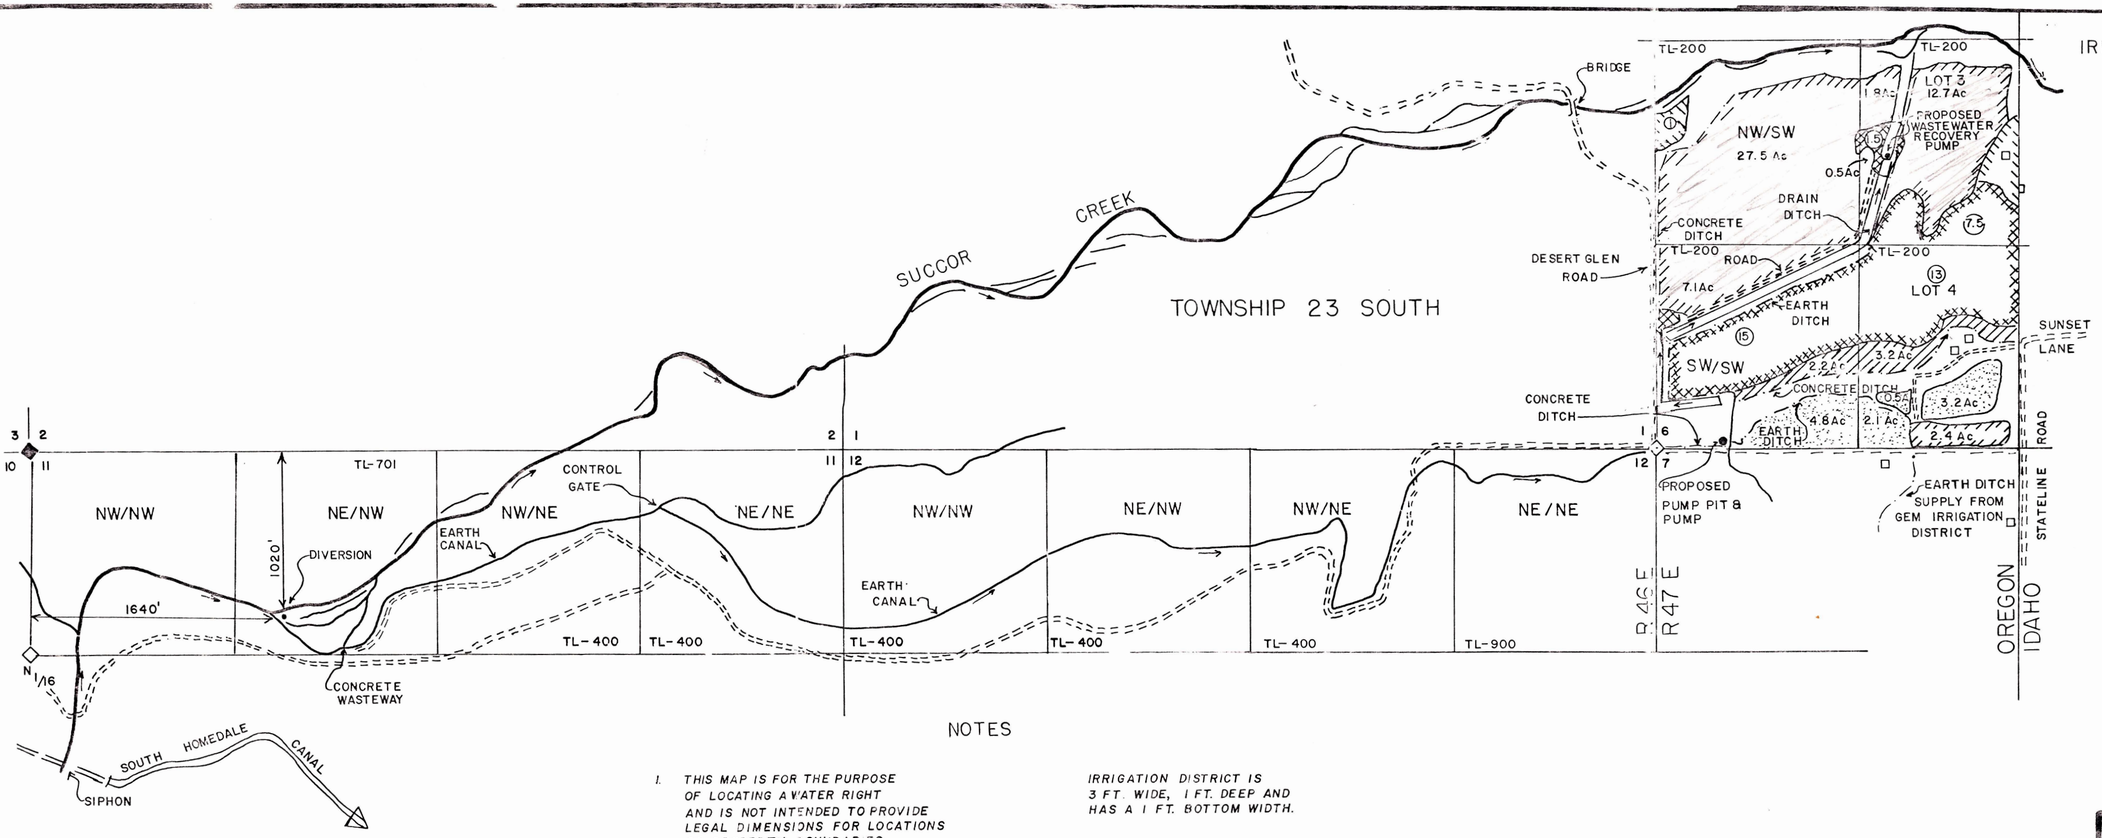

IRRIGATION SYSTEM KEY

- LOCATION OF EXISTING HEAD DITCHES
- LARGE DRAIN DITCH
- FOUND SECTION CORNER
- SEARCHED FOR SECTION CORNER-NOT FOUND
- PROPOSED PUMP LOCATIONS
- BUILDINGS
- (Ac) USBR WATER RIGHTS ACREAGE
- T.L. TAX LOT
- IRRIGATED AREA COVERED BY REGISTRATION STATEMENT
- AREA IRRIGATED UNDER USBR WATER RIGHT, CERT. 24707
- UNIRRIGATED AREA SHOWN IN USBR WATER RIGHT
- AREA OF PROPOSED IRRIGATION EXPANSION

NOTES

1. THIS MAP IS FOR THE PURPOSE OF LOCATING A WATER RIGHT AND IS NOT INTENDED TO PROVIDE LEGAL DIMENSIONS FOR LOCATIONS OF PROPERTY BOUNDARIES.
2. TAX LOT 200 IS OWNED BY MRS. CLEATHEL KNOX.
3. CONCRETE DITCHES HAVE A 1 FT BOTTOM WIDTH, 1:1 SIDE SLOPES, AND 1.2 FT DEPTH.

   THE LARGE DRAIN DITCH IS APPROXIMATELY 25 FT WIDE AND 10 FT DEEP.

   THE EARTH HEAD DITCHES ARE APPROXIMATELY 2 FT WIDE AND 1 FT DEEP.

   THE SUPPLY DITCH FROM THE GEM IRRIGATION DISTRICT IS 3 FT. WIDE, 1 FT. DEEP AND HAS A 1 FT. BOTTOM WIDTH.
4. DISTANCES SHOWN ON THIS MAP WERE OBTAINED FROM A COMBINATION OF FIELD SURVEYS AERIAL PHOTOGRAPHS.
5. OTHER TAX LOT INFORMATION
   - TAX LOT 400 – HAROLD & IRENE MARKLEY
   - TAX LOT 701 – NELSON R. JOHNSON
   - TAX LOT 900 – B. JOHNSON

Vernon R. Pritchard
Vernon R. Pritchard
Nov. 17, 1992
STATE OF OREGON

VERN PRITCHARD 473-3612
P.O. BOX 134
VALE, OREGON 97918

CLEATHEL KNOX
WATER RIGHTS APPLICATION

DRAWN Diane H. Pritchard	SCALE 1" = 660'
APPROVED Vern R. Pritchard	DWG NO. 005
DATE JUNE 30, 1991	SHEET 1 OF 1