


Section 36 Township 23S Range 12W W.M.


Coos County

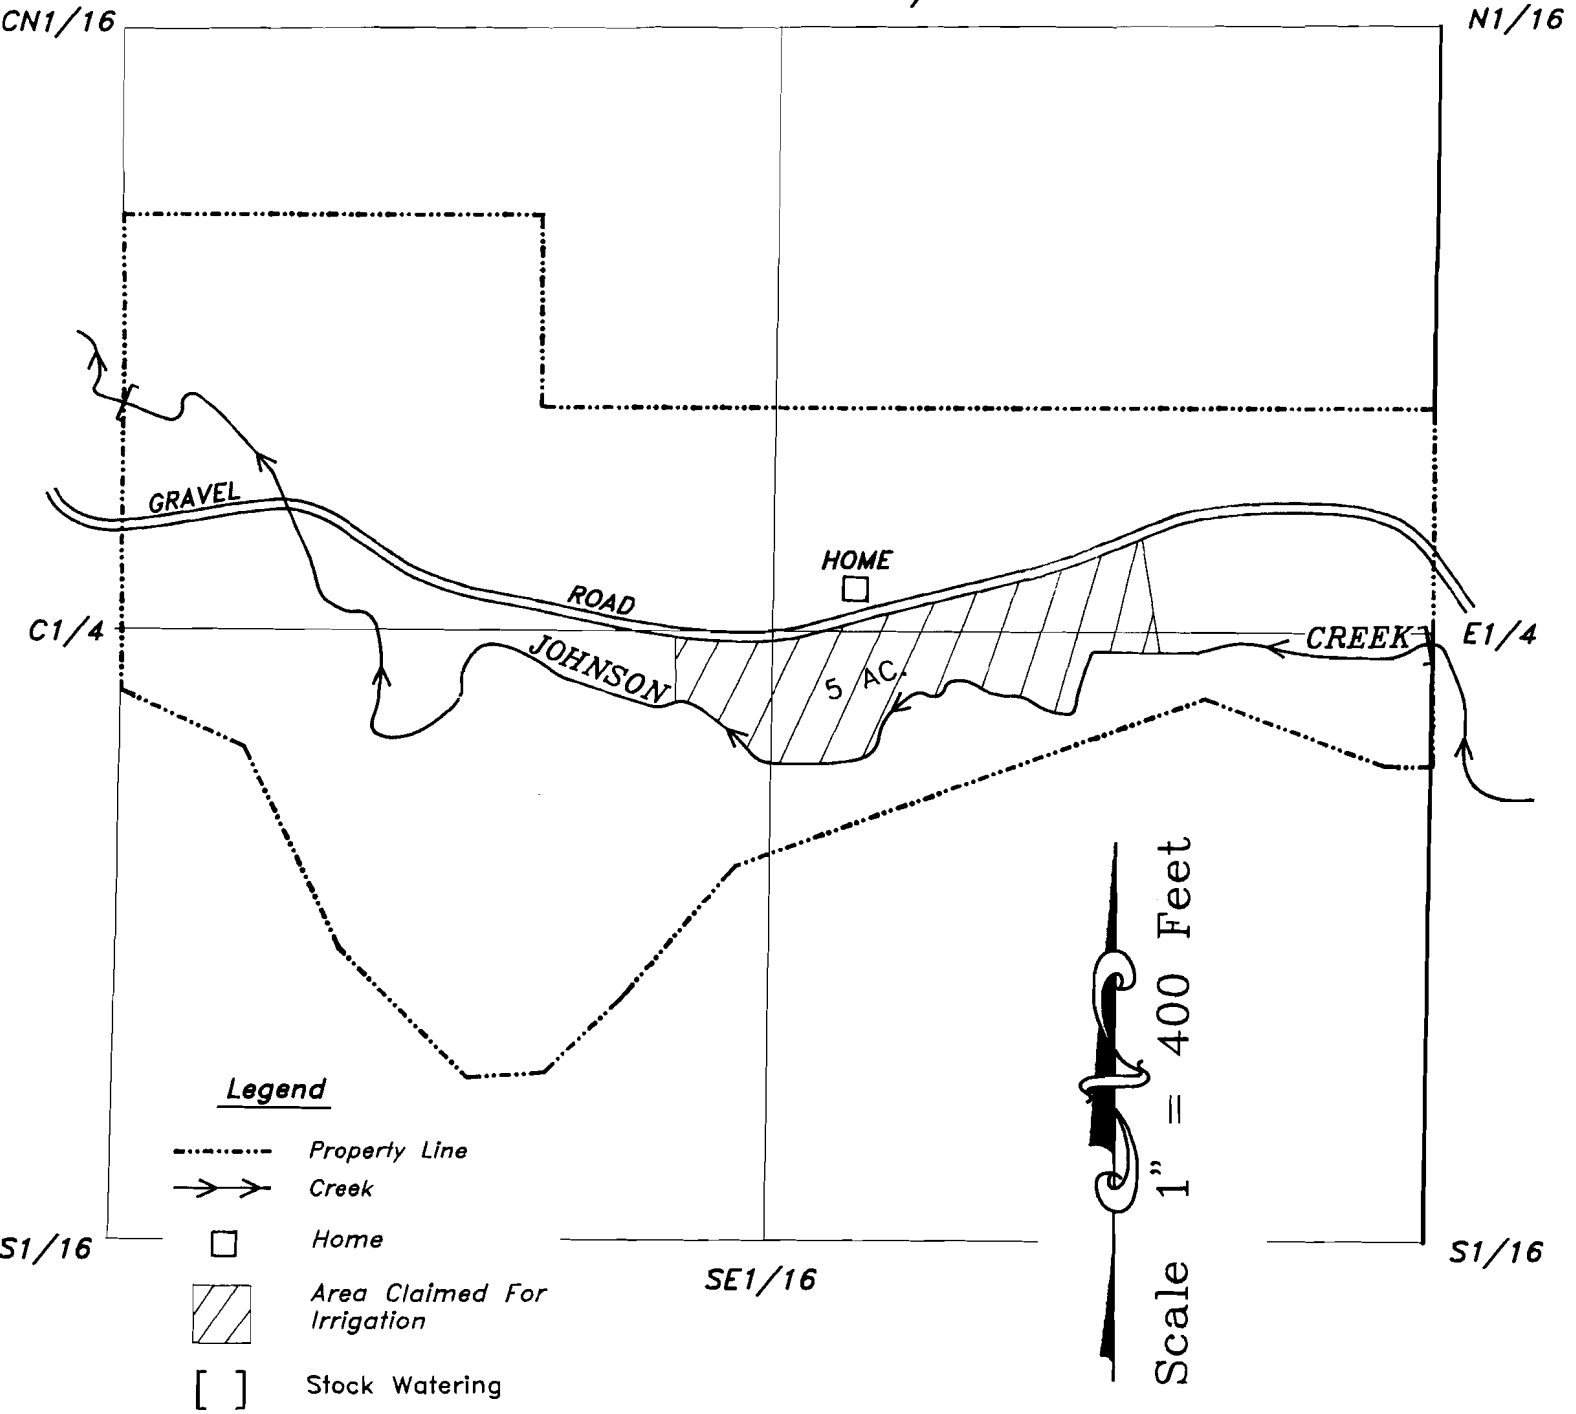

EXAMINERS DISCLAIMER STATEMENT

The preparation of this map was for the purpose of identifying the location of the Water Right only and has no intent to provide dimensions or location of property ownership lines.

PRE 1909 VESTED WATER RIGHTS SURVEY
IN THE NAME OF
Robert and Fontella Hankins

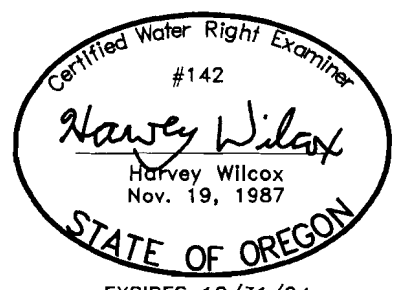

EXPIRES 12/31/94

Surveyed on January 28, 1993 by H.A. Wilcox