


CLAIM OF BENEFICIAL USE MAP  
 JAMES and EVELYN LARSON

RECEIVED

File No. SRW-456


WATER RESOURCES  

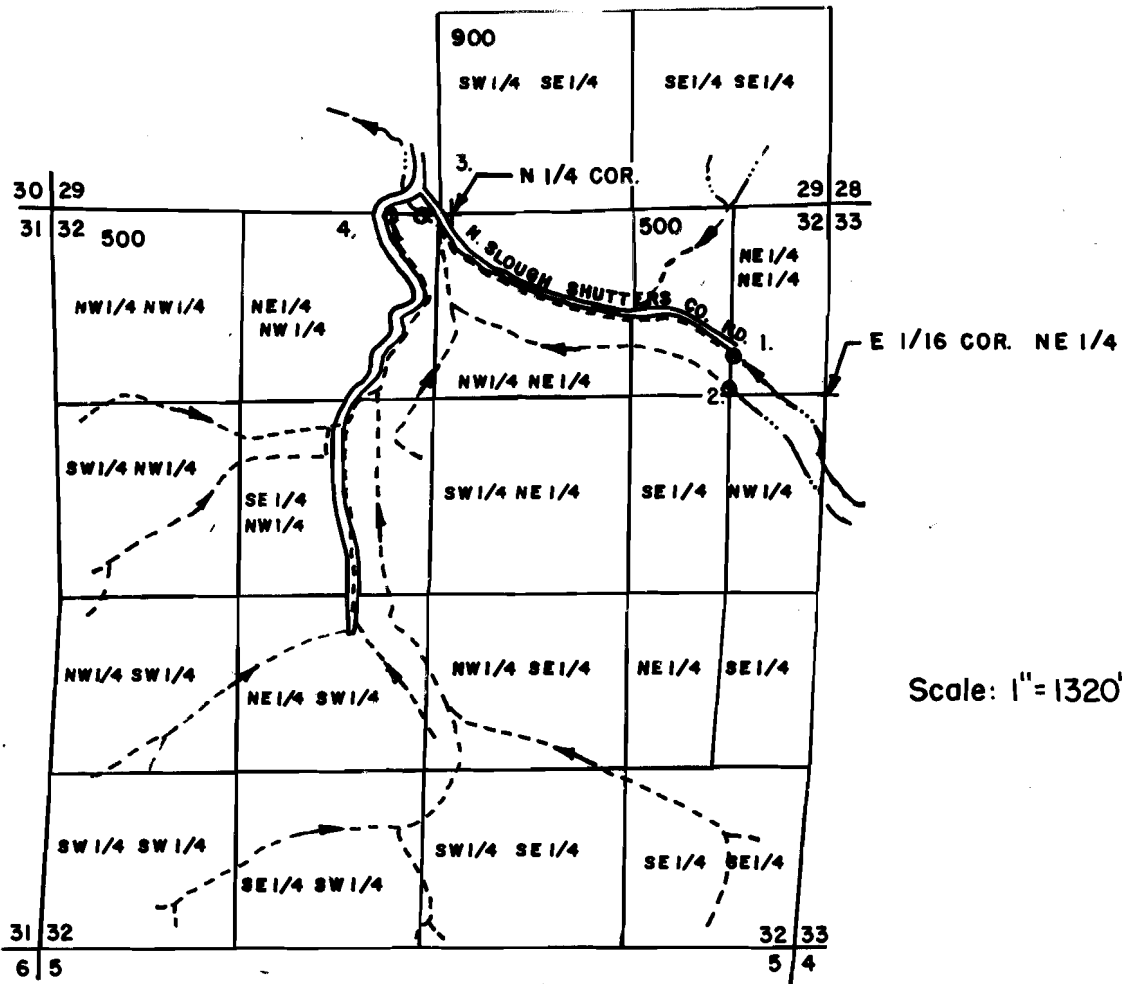

Scale: 1" = 1320'


Points of Stream Entry Onto Property

1. N 65° 38' W 705' from E 1/16 cor. NE 1/4 sec. 32
2. N 87° 54' W 654' from E 1/16 cor. NE 1/4 sec. 32

Points of Stream Exit From Property

3. N 87° 52' W 245' from N 1/4 cor., sec. 32
4. N 87° 52' W 380' from N 1/4 cor., sec. 32

--- Reach of stream used for livestock watering

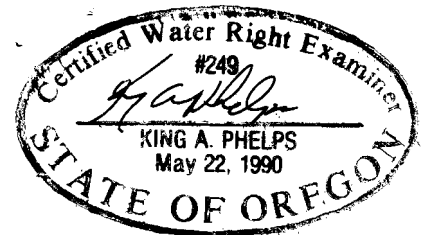

THE PURPOSE OF THIS MAP IS TO IDENTIFY THE LOCATION OF THE WATER RIGHT IT IS NOT INTENDED TO PROVIDE INFORMATION RELATIVE TO THE LOCATION OF PROPERTY OWNERSHIP BOUNDARY LINES.