


MAP BASED ON
WALLOWA COUNTY
ASSESSOR MAPS
AND ASCS AERIAL
PHOTOS

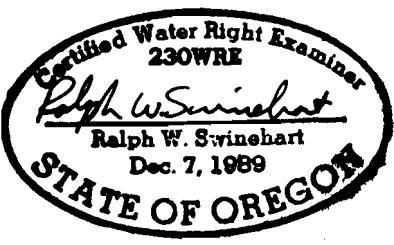

1"=2000'

THIS MAP IS PREPARED FOR
WATER RIGHT PURPOSES ONLY
AND SHOULD NOT BE USED
FOR PROPERTY LINE LOCATION
PURPOSES.

SPRING AND POINT OF USE ARE IN
THE SE 1/4, SW 1/4, SEC 31, T 6N, R 44E W.M.
SPRING IS 2040' EAST AND 150' NORTH
OF SW CORNER OF SECTION 31

THE SPRING IS A TRIBUTARY OF SQUAW
CREEK, A TRIBUTARY OF THE GRANDE
RONDE RIVER.

SEE ATTACHED SITE REPORT

SECTION 31
T 6N, R 44E, W.M.
WALLOWA COUNTY

ROBERT MORSE RANCH
PRE-1909 WATER RIGHT APPL.
DECEMBER 1992